IREDELL COUNTY HEALTH DEPARTMENT

Statesville Phone TR 3-7271 Mooresville Phone NO 3-1271

PERMIT TO INSTALL SEPTIC TANK

Permit NO. _____ Watts Bldg ~~Hog~~ Permit Date 11-3-1961

Owner Ray Warren Elder Address Kyles X Rd.

Installed By CLYDE HOKE Address _____


Location of Property Left at Kyles X Rd toward River - 1st on left.

Tank		Capacity		Length of Lines		Fixtures	
Block	( )	800	( )	150'	( )	No. of Baths	(2)
Precast	(✓)	900	( )	175'	( )	Dishwasher	( )
		1000	(✓)	200'	( )	Garbage Grdr.	( )
		1100	( )	225'	(✓)	Auto-Washer	(✓)
Hosk		1200	( )	250'	( )	Other	
		Other		Other			

NOTIFY HEALTH DEPARTMENT AT LEAST EIGHT HOURS BEFORE TANK IS TO BE INSPECTED.

Final Inspection 11-3-1961 Approved (✓) Disapproved ( )

Remarks well 80'

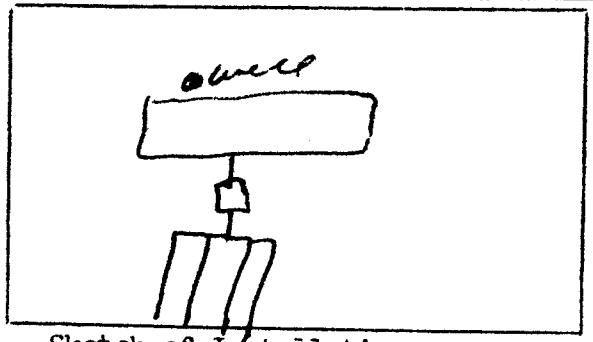

Sketch of Installation

Rat

Sanitarian