IREDELL COUNTY HEALTH DEPARTMENT - *ENVIRONMENTAL HEALTH* ☑ STATESVILLE OFFICE 704-878-5305 ☐ MOORESVILLE OFFICE 704-664-5281

IMPROVEMENT PERMIT / AUTHORIZATION TO CONSTRUCT / OPERATION PERMIT / EXISTING SYSTEM INSPECTION

PERMIT # 168136 PIN # 4722-27-3149 DATE 3 October 2011

OWNER Jerry L. Davis Heirs APPLICANT: Clayton Mobile Home PHONE: Home/Cell # (704) 239-3693 Business #

SITE ADDRESS 128 Gray Manor Dr. Stat. OWNER / APPLICANT ADDRESS

SITE DIRECTIONS I-40W - TL old NBW Rd. TR Buffalo Shoals - TL Gray Manor on RT.

SUBDIVISION BLOCK / SECTION LOT # LOT AREA 0.6ac. DESIGN FLOW 360gpd L.T.A.R. 0.3 gpd/ft²

Septic Tank Existing Gallons: STB Date

Pump Tank Gallons: P T Date

Pump Make Model Serial #

No. Nitrification Fields: 1 No. Lines 2 Linear Feet 100

Trench Width 36" Max. Trench Bottom Depth 36" Gravel Depth NA

☐ New System ☐ Repair ☑ Expansion System Type I II III IV V VI

System Description: 25% Reduction System.

Repair System Description: 25% Reduction System.

Maintenance Agreement Required ☐ YES ☑ NO

☑ GRAVITY ☐ PRESSURE

☑ Residence No. Bedrooms 3

☐ Business No. Persons

☐ Other No. Employees

☐ Slab ☑ Crawl Space

☐ Basement w/plumbing ☐ Basement w/o plumbing


Water Supply: ☑ Private Existing ☐ Public ☐ Community

Comments / Conditions

Add to existing system.

* Replace D-Box with Drop-Box.

INITIAL SITE SKETCH

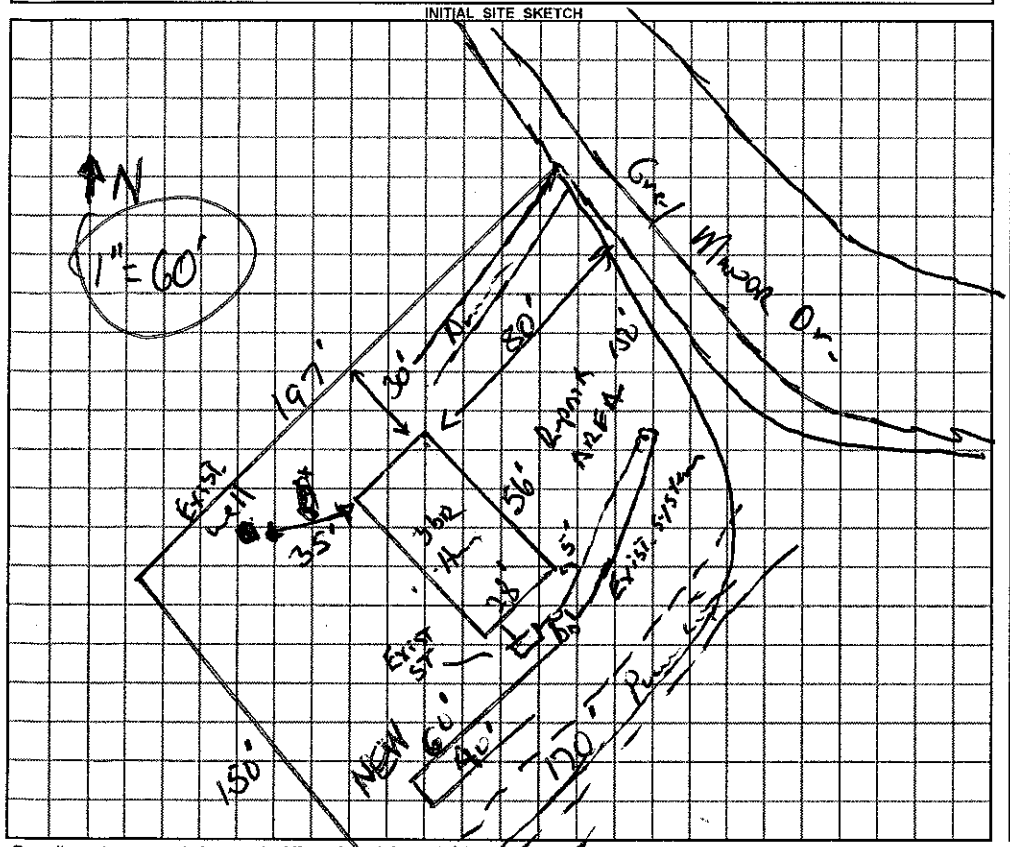

AS BUILT SKETCH

Installed As Drawn

Permit can be suspended or revoked if any false information is supplied toward securing the permit / any unauthorized changes are made to the site / any unauthorized changes are made in the installation of the system.

☐ *IMPROVEMENT PERMIT* with plat valid without expiration. ☑ *IMPROVEMENT PERMIT* with ~~plat~~ site plan valid 60 mo. ☑ *AUTHORIZATION TO CONSTRUCT* valid for period equal to IMPROVEMENT PERMIT--not to exceed 60 mo.

Owner / Applicant Signature: Date 10/5/11 Installed by: Tim Abell

IMPROVEMENT PERMIT by: REHS Date 30 Oct. 11 OPERATION PERMIT by: REHS Date 3 Jan. 12

AUTHORIZATION TO CONSTRUCT by: REHS Date 30 Oct. 11 Existing System Inspected by: REHS Date

YOU SHOULD CONTACT A LOCATOR SERVICE PRIOR TO ANY EXCAVATION

White Copy – Environmental Health YELLOW COPY (Final) Owner / Applicant PINK COPY (Initial) Owner / Applicant