75294

IREDELL COUNTY HEALTH DEPARTMENT

STATESVILLE 704-878-5305 MOORESVILLE 704-664-5281

IMPROVEMENT PERMIT / AUTHORIZATION TO CONSTRUCT / OPERATION PERMIT / EXISTING SYSTEM INSPECTION

PERMIT# 26092 PIN# 4722325464

OWNER OR CONTRACTOR Chris Dawson PHONE: Business 528-6192 Home DATE 6-17-98

ADDRESS PO Box 5602 Statesville

LOCATION OMP Lt kyleswood Subdivision Before Buffalo Shoals Rd, 2ND LOT ON LEFT

SUBDIVISION kyleswood BLOCK / SECTION LOT 2 LOT AREA SITE CLASS. P/S DESIGN FLOW 360 L.T.A.R. 0.3

Septic Tank: 1000 Gallons; STB 1012 Date 9-19-98

Pump Tank: Gallons; PT Date

Pump Make: Model Serial No.

Nitrification Field: No Fields 1 Square Feet 900 Linear Feet 300

No Lines 4 Trench Width 36 Max Trench Bottom Depth 36 Gravel Depth Sand

X New System ☐ Repair System Type: I, II, III, IV, V, VI

System Description: Grant Chamber/HDS

Repair System Description: Pump Chamber/Pump

Maintenance Agreement Required: ☐ Yes ☐ No

X House/Mod. Home ☐ Mobile Home ☐ Business ☐ Other

No. Bedrooms 3 No. Bathrooms 2 No. Employees


☐ Slab X Crawl Space ☐ Basement w/plumbing ☐ Basement wo/plumbing

Water Supply: ☐ Individual ☐ Public ☐ Community well

Comments:/Conditions: keep lines on contour
9ft on center
keep water line 10ft from system

Comments:/Conditions:

INITIAL SITE SKETCH

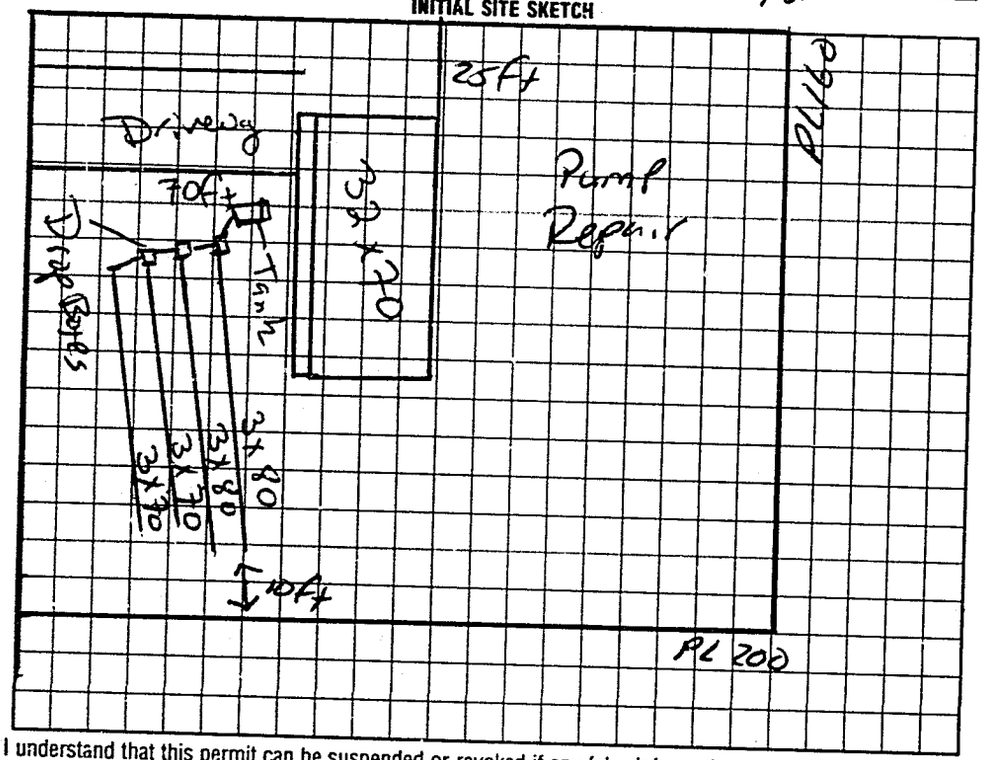

AS BUILT SKETCH

SYSTEM INSTALLED ACCORDING TO INITAL SITE SKETCH USING FIFTY CHAMBERS

I understand that this permit can be suspended or revoked if any false information is supplied toward securing the permit/any unauthorized changes are made to the site/any unauthorized changes are made in the installation of the system. Improvement Permit with plat valid without expiration. Improvement Permit with site plan valid for sixty months. Authorization to Construct is valid for a period equal to that of Improvement Permit – not to exceed sixty months.

Signed: [signature]

Improvement Permit by: Mark Court RS date 6-17-98

Authorization to Construct by: Mark Court RS date 6-17-98

Installed by: DAVID YOUNTZ

Operation Permit by: STEVE HORICK date 12-1-98

Existing System Inspection by: date

HEALTH DEPT. COPY: WHITE INSPECTION COPY (FINAL) GREEN OWNER COPY (FINAL) YELLOW INSPECTION COPY (INITIAL) PINK OWNER COPY (INITIAL) GOLD