IREDELL COUNTY HEALTH DEPARTMENT

STATESVILLE 704-878-5305 MOORESVILLE 704-664-5281

IMPROVEMENT PERMIT / CERTIFICATE OF COMPLETION / OPERATION PERMIT / EXISTING SYSTEM INSPECTION

PROPERTY DESCRIPTION NO. 26093 DATE 10-7-97 TAX MAP NO. 47223 85864 pt Watershed: ☐ Yes ☐ No

OWNER OR CONTRACTOR Chris Davidson (Kyle Deve Painters) PHONE: Business 528-6192 Home WSIUPA

ADDRESS PO Box 5002 Statesville NC

LOCATION 40W TL Old Mtn Rd TL Kylewood 3rd lt on Left

SUBDIVISION Kylewoods BLOCK / SECTION ____ LOT 3 LOT AREA 31,999 SITE CLASS. P/S DESIGN FLOW 360 L.T.A.R. 0.3

Septic Tank: 1000 Gallons; STB 1012 Date 1-20-98

Pump Tank: ____ Gallons; PT ____ Date ____

Pump Make: ____ Model ____ Serial No. ____

Nitrification Field: No Fields 1 Square Feet 1200 Linear Feet 400

No Lines 5 Trench Width 36in Max Trench Bottom Depth 36in Gravel Depth 12in

☒ New System ☐ Repair System Type: I, II, III, IV, V, VI

System Description: Grade Conventional

Repair System Description: Pump Conventional

Maintenance Agreement Required: ☐ Yes ☒ No Chamber

☒ House/Mod. Home No. Bedrooms 3

☐ Mobile Home No. Bathrooms 2

☐ Business No. Employees ____

☐ Other ____


☐ Slab ☒ Crawl Space ☐ Basement w/plumbing ☐ Basement wo/plumbing

Water Supply:
☐ Individual
☒ Community
☐ Public
well

Comments: Keep Lines on center 9ft on center
keep water line 10 ft from system

Comments:

INITIAL SITE SKETCH

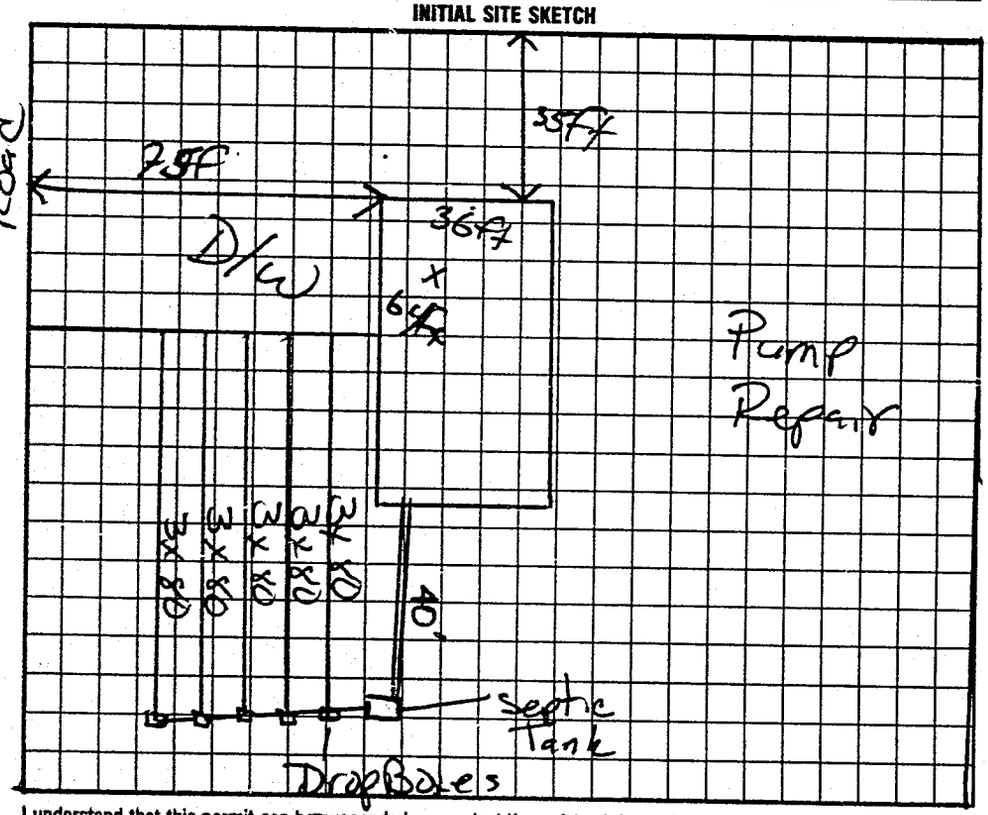

AS BUILT SKETCH

I understand that this permit can be suspended or revoked if any false information is supplied toward securing the permit/any unauthorized changes are made to the site/any unauthorized changes are made in the installation of the system. Improvement Permit is valid for 60 months from date of issuance.

Signed: ____

Improvement Permit by: Mary C Ott RS date 10-7-97

Authorization to Construct by: Mary C Ott RS date 10-7-97

Installed by: DAVID YOUNTS

Certificate of Completion by: ____ date ____

Operation Permit by: STEVE HEDRICK date 2-6-98

HEALTH DEPT. COPY: WHITE INSPECTION COPY (FINAL): GREEN OWNER COPY (FINAL): YELLOW INSPECTION COPY (INITIAL): PINK OWNER COPY (INITIAL): GOLD

85000