IREDELL COUNTY HEALTH DEPARTMENT

STATESVILLE 704-878-5305 MOORESVILLE 704-664-5281

IMPROVEMENT PERMIT / AUTHORIZATION TO CONSTRUCT / OPERATION PERMIT / EXISTING SYSTEM INSPECTION

PERMIT# ~~REPAIR~~ EXPANSION PIN# 4722-28-8115 DATE 4-10-06

OWNER OR CONTRACTOR JOE LINGLE PHONE: Business 704-528-4759 Home

ADDRESS 907 OLD MOUNTAIN ROAD STATESVILLE, NC 28625

LOCATION I-40 WEST, TL OLD MOUNTAIN ROAD, ON RIGHT AT BUFFALO SHOALS ROAD.

SUBDIVISION BLOCK / SECTION LOT LOT AREA ~2 ACRES SITE CLASS PS DESIGN FLOW 1080 (ex) L.T.A.R. EXISTING

GREASE

Septic Tank: 1000 Gallons; STB 1000 DB Date 10-3-05

Pump Tank: Gallons; PT Date

Pump Make: Model Serial No.

Nitrification Field: No Fields 1 Square Feet 900 Linear Feet EXISTING

No Lines TWO Trench Width 36" Max Trench Bottom Depth Gravel Depth 12"

☑ New System ☐ Repair System Type: I, II, III, IV, V, VI

System Description: CONVENTIONAL, GRAVITY

Repair System Description:

Maintenance Agreement Required: ☐ Yes ☑ No

☐ House/Mod. Home No. Bedrooms

☐ Mobile Home No. Bathrooms

☑ Business No. Employees

☐ Other SEE COMMENTS

☑ Slab ☐ Crawl Space ☐ Basement w/plumbing ☐ Basement wo/plumbing


Water Supply: ☐ Individual ☑ Public ☐ Community WELL

Comments:/Conditions: THIS PERMIT IS TO ADD GREASE TRAP TO EXISTING FACILITY CONSISTING OF ① SERVICE STATION W/ ONE WATER CLOSET ② RETAIL STORE @ 4880 ft² ③ FOOD STAND @ 240 ft² & ④ OFFICE @ 100 GPD - SYSTEM UNDERSIZED BY TODAY'S STANDARDS

Comments:/Conditions:

INITIAL SITE SKETCH

AS BUILT SKETCH

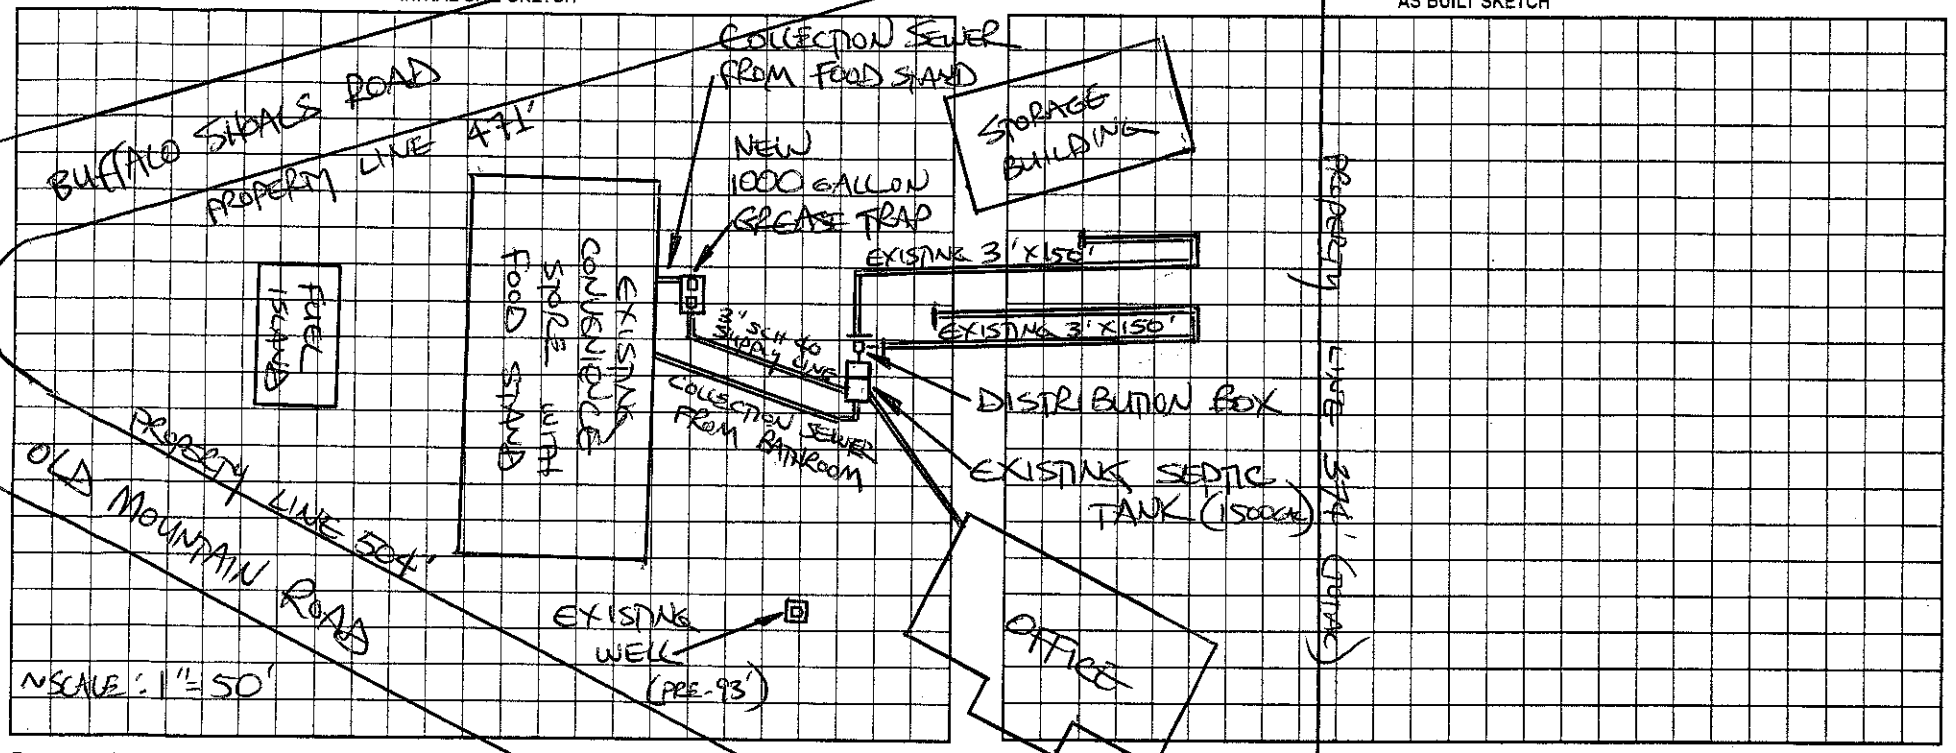

Permit can be suspended or revoked if any false information is supplied toward securing the permit/any unauthorized changes are made to the site/any unauthorized changes are made in the installation of the system. Improvement Permit with plat valid without expiration. Improvement Permit with site plan valid for sixty months. Authorization to Construct is valid for a period equal to that of Improvement Permit – not to exceed sixty months.

Signed: date 4-10-06 Installed by: LANCE LINGLE

Improvement Permit by: STEVE HEDRICK date 4-10-06 Operation Permit by: STEVE HEDRICK date 3-1-2011

Authorization to Construct by: STEVE HEDRICK date 4-10-06 Existing System Inspection by: date

HEALTH DEPT. COPY: WHITE OWNER COPY (FINAL): YELLOW OWNER COPY (INITIAL): PINK