IREDELL COUNTY HEALTH DEPARTMENT

This permit voids Permit dated 11-21-96

STATESVILLE 704-878-5305 MOORESVILLE 704-664-5281

IMPROVEMENT PERMIT / CERTIFICATE OF COMPLETION / OPERATION PERMIT / EXISTING SYSTEM INSPECTION

PROPERTY DESCRIPTION NO. 25001 DATE 2-14-97 TAX MAP NO. 35-3-A-1

OWNER OR CONTRACTOR Chris Davidson PHONE: Business 528-6192 Home Watershed: ☐ Yes ☐ No W3IV PA

ADDRESS PO Box 5602 Statesville NC

LOCATION Buffalo Shoals TR Old Mtn Rd TR Pinkley Rd [First Pave Rt on Rt) First lot Rt

SUBDIVISION Kirkwood BLOCK / SECTION LOT 14 LOT AREA 32,000 sq ft SITE CLASS D/S DESIGN FLOW 360 L.T.A.R. 0.3

Septic Tank: 1000 Gallons; STB 1012 Date 3-1-97

Pump Tank: Gallons; PT Date

Pump Make: Model Serial No.

Nitrification Field: No Fields 1 Square Feet 900 Linear Feet 300

No Lines 6 Trench Width 36 in Max Trench Bottom Depth 36 in Gravel Depth Sand

☒ New System ☐ Repair System Type: I, II, III, IV, V, VI

System Description: Gravity Chambers

Repair System Description: Pump Chambers

Maintenance Agreement Required: ☐ Yes ☐ No

☒ House/Mod. Home ☐ Mobile Home ☐ Business ☐ Other

No. Bedrooms 3 No. Bathrooms 2 No. Employees


☐ Slab ☒ Crawl Space ☐ Basement w/plumbing ☐ Basement wo/plumbing

Water Supply: ☐ Individual ☐ Community ☐ Public


Comments: Keep lines on contour 9 ft on center - 7 trenches each line
Keep system soft from well
community well may be installed keep system 100 ft

Comments:

INITIAL SITE SKETCH

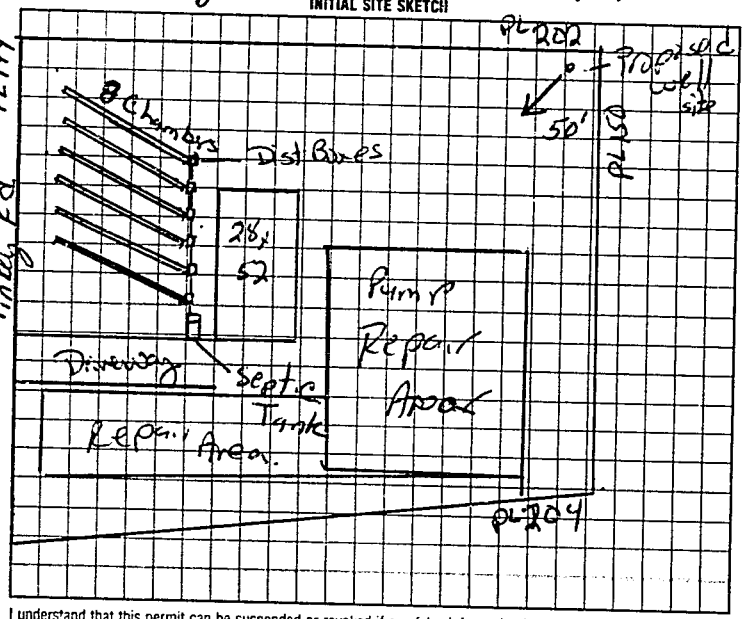

AS BUILT SKETCH

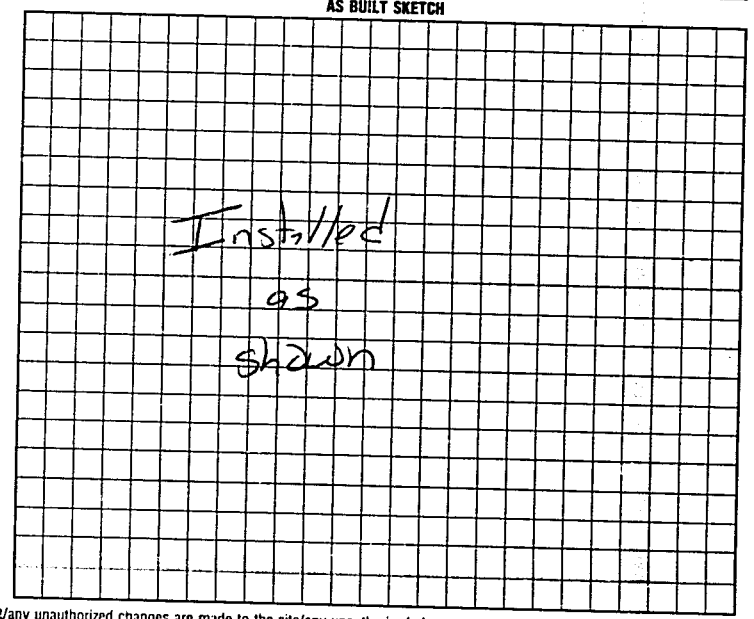

I understand that this permit can be suspended or revoked if any false information is supplied toward securing the permit/any unauthorized changes are made to the site/any unauthorized changes are made in the installation of the system. Improvement Permit is valid for 60 months from date of issuance. Authorization to construct expires 5yrs from issue date

Signed: Neal J Kelly

Improvement Permit by: Mark C Orf date 2-14-97

Existing System Inspection by: Authorization to construct Mark C Orf date 2-14-97

Installed by: David Yantz

Certificate of Completion by: date

Operation Permit by: Mark C Orf RS date 4-25-97

HEALTH DEPT COPY: WHITE INSPECTION COPY (FINAL): GREEN OWNER COPY (FINAL): YELLOW INSPECTION COPY (INITIAL): PINK OWNER COPY (INITIAL): GOLD