IREDELL COUNTY HEALTH DEPARTMENT

STATESVILLE 704-878-5305 MOORESVILLE 704-664-5281

IMPROVEMENT PERMIT / CERTIFICATE OF COMPLETION / OPERATION PERMIT / EXISTING SYSTEM INSPECTION

PROPERTY DESCRIPTION NO. 2609E 06/99 DATE 2-14-97 TAX MAP NO. 4722385864 pt

OWNER OR CONTRACTOR Kyles Dev Partners (Chris Davidson) PHONE: Business 528-6192 Home

Watershed: ☐ Yes ☐ No WS IV PA

ADDRESS PO Box 5602 Statesville NC

LOCATION Buffalo shoals Rd TR Oldmtn Rd TR 1st Paved Rd (Pinkey Way)

SUBDIVISION BLOCK / SECTION LOT 13 LOT AREA 32,445 sqft SITE CLASS. PS DESIGN FLOW 360 L.T.A.R. 0.3

Septic Tank: 1000 Gallons; STB 1012 Date 5-7-97

Pump Tank: Gallons; PT Date

Pump Make: Model Serial No.

Nitrification Field: No Fields 1 Square Feet 900 Linear Feet 300

No Lines 4 Trench Width 36in Max Trench Bottom Depth 35in Gravel Depth sand

☒ New System ☐ Repair System Type: I, II, III, IV, V, VI

System Description: Crawl Chambers

Repair System Description: Pump shallow chambers

Maintenance Agreement Required: ☐ Yes ☒ No

☐ Slab ☒ Crawl Space ☐ Basement w/plumbing ☐ Basement wo/plumbing

☒ House/Mod. Home No. Bedrooms

☐ Mobile Home No. Bathrooms

☐ Business No. Employees


☐ Other

Water Supply:
☐ Individual
☐ Community
☐ Public


Comments: keep lines on contour, 9ft on center
keep well 50ft from system (possible community well may be installed)
Community well must be 100ft from systems

Comments:

INITIAL SITE SKETCH

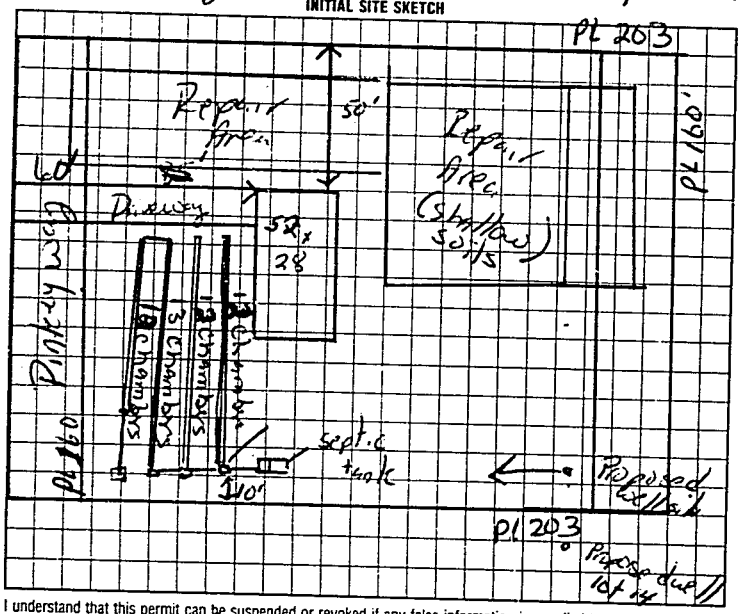

AS BUILT SKETCH

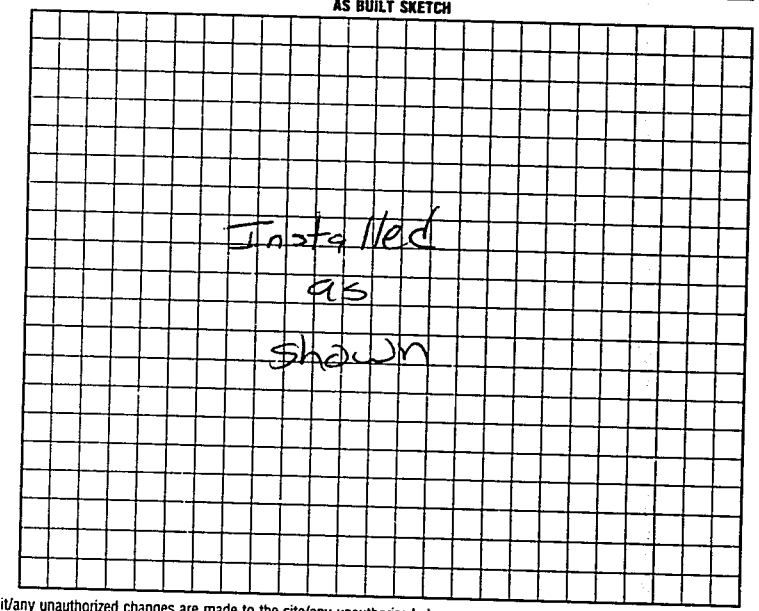

I understand that this permit can be suspended or revoked if any false information is supplied toward securing the permit/any unauthorized changes are made to the site/any unauthorized changes are made in the installation of the system. Improvement Permit is valid for 60 months from date of issuance. Authorization to construct expires 5 yrs from issue date

Signed: X Neal Kyles

Improvement Permit by: Mark C Outlaw RS date 2-14-97

~~Existing System inspection by:~~ Authorization to Const Mark C Outlaw RS date 2-14-97

Installed by: David Yount

Certificate of Completion by: date

Operation Permit by Mark C Outlaw RS date 7-10-97

HEALTH DEPT COPY: WHITE INSPECTION COPY (FINAL): GREEN OWNER COPY (FINAL): YELLOW INSPECTION COPY (INITIAL): PINK OWNER COPY (INITIAL): GOLD