This Voids All Previous Dated Permits

IREDELL COUNTY HEALTH DEPARTMENT

STATESVILLE 704-878-5305 MOORESVILLE 704-664-5281

IMPROVEMENT PERMIT / AUTHORIZATION TO CONSTRUCT / OPERATION PERMIT / EXISTING SYSTEM INSPECTION

PERMIT# 83186 PIN# 4722226589 DATE March 29, 2000

OWNER OR CONTRACTOR Stanley Fine PHONE: Business _____ Home 878-0147

ADDRESS 1824-A Simonton Rd Statesville, NC 28677

LOCATION Old Mt Rd South (R) Compton Park (R) Idlebrook (L) Brandenburg Lot on Left 2nd curve

SUBDIVISION Stonecrest BLOCK / SECTION _____ LOT 11 LOT AREA 0.94 SITE CLASS A5 DESIGN FLOW 360 L.T.A.R. .3

Septic Tank: 1000 Gallons; STB 156 Date 2-22

Pump Tank: _____ Gallons; PT HP Date _____

Pump Make: _____ Model _____ Serial No. _____

Nitrification Field: No Fields 1 Square Feet 1200 Linear Feet 400

No Lines 5 Trench Width 36" Max Trench Bottom Depth 36" Gravel Depth 12"

☒ New System ☐ Repair System Type: I (II) III IV V VI

System Description: GRAVITY Conventional

Repair System Description: 25% Reduction Rep Possible

Maintenance Agreement Required: ☐ Yes ☒ No

☐ House/Mod. Home ☒ Mobile Home ☐ Business ☐ Other

☐ Slab ☒ Crawl Space ☐ Basement w/plumbing ☐ Basement wo/plumbing


No. Bedrooms 3 No. Bathrooms 2 No. Employees ____

Water Supply: ☒ Individual ☐ Public ☐ Community WELL


Comments/Conditions: Use Speed Levels To Feed Both 55 Ft Lines 1st And To Feed The 110 Ft Lines At Same Time

Comments/Conditions: Zable Filter used 4-7: Top 4 Lines installed As Shown

INITIAL SITE SKETCH

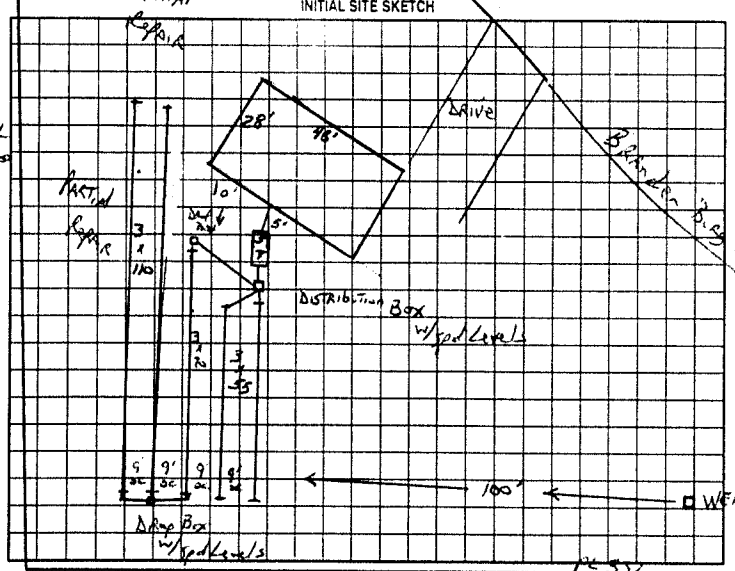

AS BUILT SKETCH

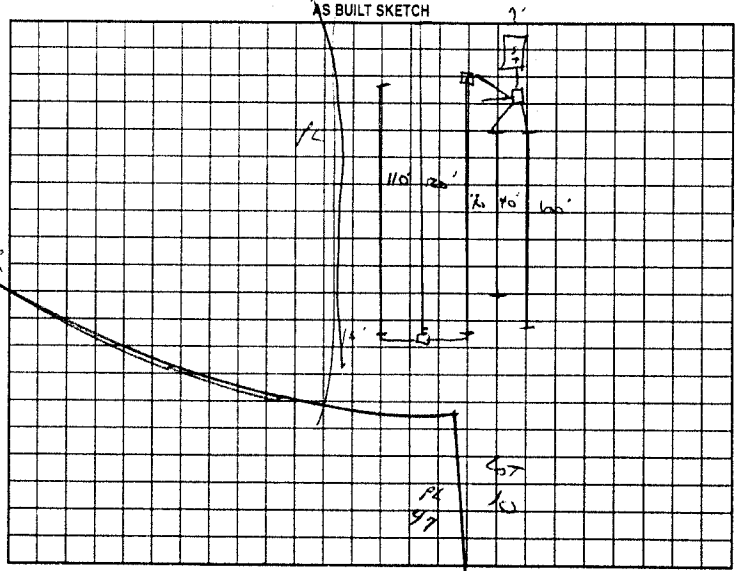

Permit can be suspended or revoked if any false information is supplied toward securing the permit/any unauthorized changes are made to the site/any unauthorized changes are made in the installation of the system. Improvement Permit with plat valid without expiration. Improvement Permit with site plan valid for sixty months. Authorization to Construct is valid for a period equal to that of Improvement Permit – not to exceed sixty months.

Signed: Stanley Fine date 3-24-00 Installed by: J. Rod Trucking

Improvement Permit by: J.C. Potter date March 29 2000 Operation Permit by: J.C. Potter date April 10 2000

Authorization to Construct by: J.C. Potter date March 29 2000 Existing System Inspection by: _____ date _____

HEALTH DEPT. COPY: WHITE OWNER COPY (FINAL): YELLOW OWNER COPY (INITIAL): PINK