CALLED IN!

# IREDELL COUNTY HEALTH DEPARTMENT

STATESVILLE 704-878-5305 MOORESVILLE 704-664-5281

## IMPROVEMENT PERMIT / AUTHORIZATION TO CONSTRUCT / OPERATION PERMIT / EXISTING SYSTEM INSPECTION

PERMIT# 93673 PIN# 4722226589 DATE 10-6-99

OWNER OR CONTRACTOR Land Development service PHONE: Business 528 4711 Home

ADDRESS PO Box 5602 Sta, N.C. 28687

LOCATION Old mtn Rd To Compton Park TR Idlebrook TR Brandenburg on Rt

SUBDIVISION Stonecrest BLOCK / SECTION 2 LOT 29 LOT AREA 1.53 acres SITE CLASS. PS DESIGN FLOW 360 L.T.A.R. .13

Septic Tank: 1000 Gallons; STB 825 Date 5-4-01
Pump Tank: Gallons; PT Date
Pump Make: Model Serial No.
Nitrification Field: No Fields Square Feet 900 Linear Feet 300
No Lines 4 Trench Width 36" Max Trench Bottom Depth 36"

☑ New System ☐ Repair System Type: I, II, III, IV, V, VI
System Description: Gravity 25% Reduct.
Repair System Description: " " "
Maintenance Agreement Required: ☐ Yes ☑ No
Gravel Depth N/A ☐ Slab ☑ Crawl Space ☐ Basement w/plumbing ☐ Basement wo/plumbing


☑ House/Mod. Home No. Bedrooms 3
☐ Mobile Home No. Bathrooms 2
☐ Business No. Employees
☐ Other

Water Supply: ☑ Individual ☐ Public ☐ Community


Comments/Conditions: ① 2ND LINE HAS 4" per 10' of fall
ALLOWABLE BY RULES ② NEED TO [illegible] LONGER DROP BOXES SO WILL BACK UP TO BOX, FROM CHAMBER LINE

Comments/Conditions: INSTALLED AS SHOWN WITH ADVANTEX FILTER
3 MARKER

INITIAL SITE SKETCH

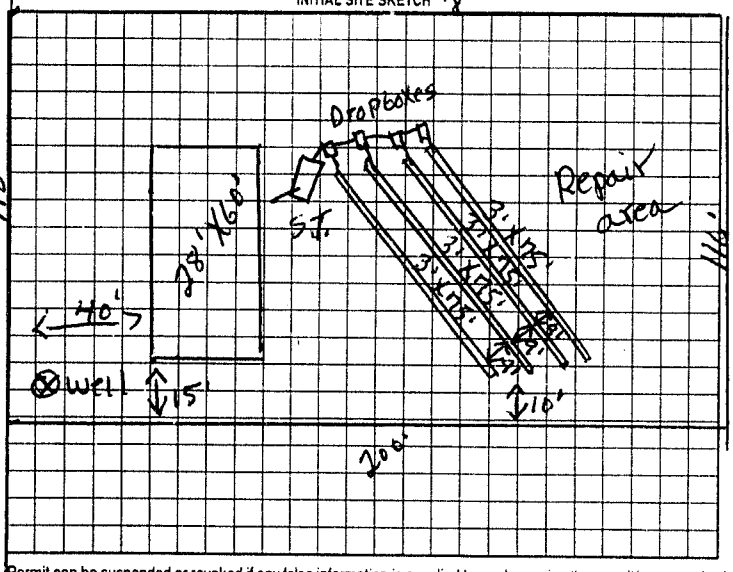


AS BUILT SKETCH

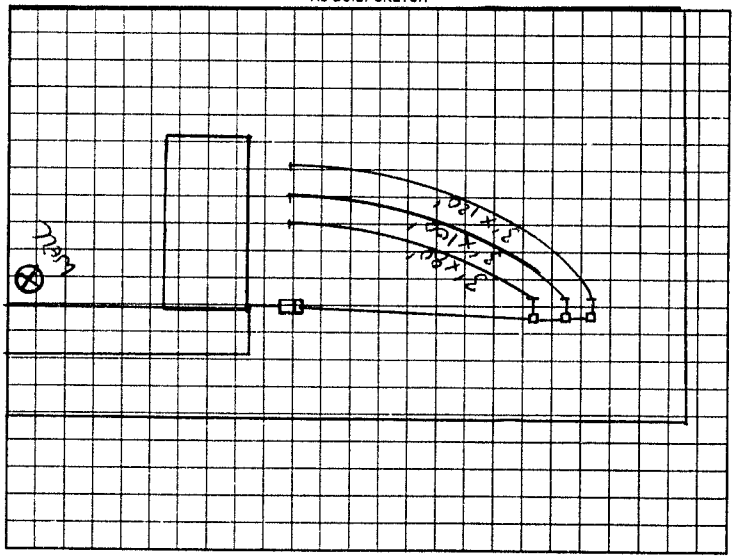


Permit can be suspended or revoked if any false information is supplied toward securing the permit/any unauthorized changes are made to the site/any unauthorized changes are made in the installation of the system. Improvement Permit with plat valid without expiration. Improvement Permit with site plan valid for sixty months. Authorization to Construct is valid for a period equal to that of Improvement Permit – not to exceed sixty months.

Signed: [signature] date 10/13/99 Installed by: BOB'S BACKHOE

Improvement Permit by: J. C. Moore date 10-6-99 Operation Permit by: [signature] RE date 9-10-01

Authorization to Construct by: J. C. Moore date 10-6-99 Existing System Inspection by: date

HEALTH DEPT COPY: WHITE OWNER COPY (FINAL): YELLOW OWNER COPY (INITIAL): PINK