IREDELL COUNTY HEALTH DEPARTMENT

STATESVILLE 704-878-5305 MOORESVILLE 704-664-5281

IMPROVEMENT PERMIT / AUTHORIZATION TO CONSTRUCT / OPERATION PERMIT / EXISTING SYSTEM INSPECTION

PERMIT# 62094 PIN# 4722226589 DATE 7-6-99

OWNER OR CONTRACTOR Land Development PHONE: Business 528 6192 Home

ADDRESS PO Box 5602 Statesville

LOCATION OWR Turn Compton DR TR Tidlebrook Th Brantenburg 5th lot Rt.

SUBDIVISION Stonecrest BLOCK / SECTION LOT 5 LOT AREA 192 acres SITE CLASS P5 DESIGN FLOW 760 L.T.A.R. .13

Septic Tank: 1000 Gallons; STB 312 Date 7-2-01
Pump Tank: Gallons; PT Date
Pump Make: Model Serial No.
Nitrification Field: No Fields 1 Square Feet 1200 Linear Feet 400
No Lines 4 Trench Width 36" Max Trench Bottom Depth 36" Gravel Depth 12"

☒ New System ☐ Repair System Type: ☐ I ☐ II ☐ III ☐ IV ☐ V ☐ VI
System Description: Conv. Gravity
Repair System Description: Gravity 252 Rock
Maintenance Agreement Required: ☐ Yes ☐ No


☒ House/Mod. Home No. Bedrooms 3
☐ Mobile Home No. Bathrooms 2
☐ Business No. Employees
☐ Other
☐ Slab ☒ Crawl Space ☐ Basement w/plumbing ☐ Basement wo/plumbing

Water Supply: ☒ Individual ☐ Public ☐ Community


Comments/Conditions:

Comments/Conditions: ZABEL FILTER & MANIFOLD INSTALLED AS SHOWN BELOW

INITIAL SITE SKETCH

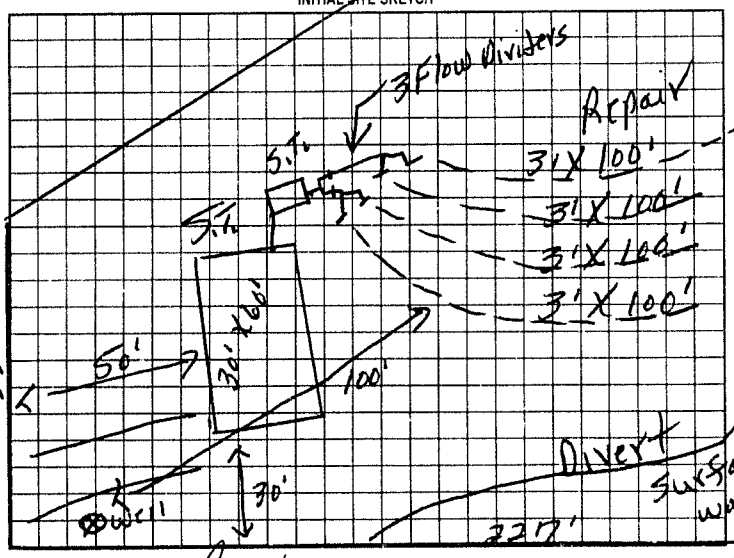

AS BUILT SKETCH

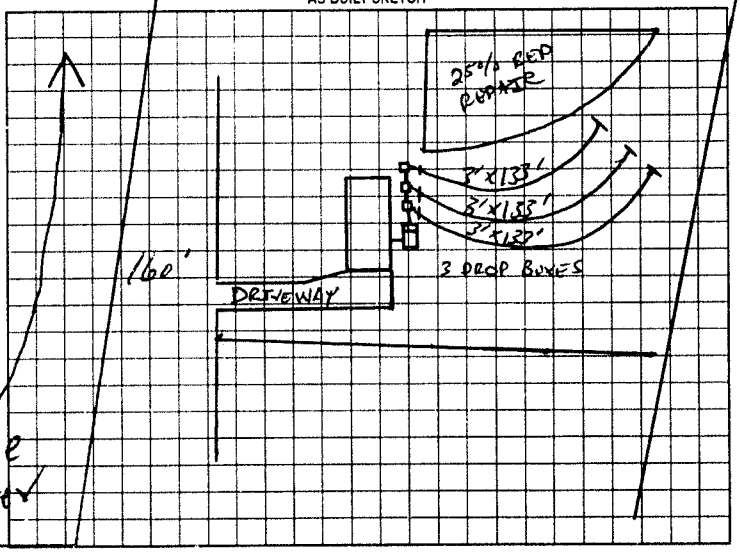

Permit can be suspended or revoked if any false information is supplied toward securing the permit/any unauthorized changes are made to the site/any unauthorized changes are made in the installation of the system. Improvement Permit with plat valid without expiration. Improvement Permit with site plan valid for sixty months. Authorization to Construct is valid for a period equal to that of Improvement Permit – not to exceed sixty months.

Signed: [signature] date 7-19-99 Installed by: Craig Thompson & Jonny Frye

Improvement Permit by: E. C. Moore date 7-6-99 Operation Permit by: [signature] RS date 8-13-01

Authorization to Construct by: E. C. Moore date 7-6-99 Existing System Inspection by: date

HEALTH DEPT. COPY WHITE OWNER COPY (FINAL) YELLOW OWNER COPY (INITIAL) PINK