# IREDELL COUNTY HEALTH DEPARTMENT

STATESVILLE 704-878-5305 MOORESVILLE 704-664-5281

## IMPROVEMENT PERMIT / AUTHORIZATION TO CONSTRUCT / OPERATION PERMIT / EXISTING SYSTEM INSPECTION

PERMIT# 83179 PIN# 4722226589 DATE Aug 23, 99

OWNER OR CONTRACTOR Land Development Services PHONE: Business 528 6192 Home

ADDRESS P.O. Box 5602 Statesville, NC

LOCATION Old MT Rd South (R) Compton Park (R) Tollabrook (L) Brandenburg Lot on Left

SUBDIVISION Stonecrest BLOCK / SECTION 11 LOT 10 LOT AREA .78 SITE CLASS PS DESIGN FLOW 360 L.T.A.R. .03

Septic Tank: 1000 Gallons; STB 1012 Date 9-16-01
Pump Tank: Gallons; PT Date
Pump Make: Model Serial No.
Nitrification Field: No Fields 1 Square Feet 1200 Linear Feet 300
No Lines 4 Trench Width 36" Max Trench Bottom Depth 36"

☒ New System ☐ Repair System Type: I, II, ☒ IV, V, VI
System Description: 25% Reduction Gravity
Repair System Description: Same 50% possible
Maintenance Agreement Required: ☐ Yes ☒ No
Gravel Depth NA ☐ Slab ☒ Crawl Space ☐ Basement w/plumbing ☐ Basement wo/plumbing


☒ House/Mod. Home No. Bedrooms 3
☐ Mobile Home No. Bathrooms 2
☐ Business No. Employees
☐ Other

Water Supply: ☒ Individual ☐ Public ☐ Community
well


Comments/Conditions: Install on Contour
Keep well 100ft or maximum Feasible distance from All Septic Systems
50 Chambers or 30 HDS Sections

Comments/Conditions Septic Tank Marker Installed
- Poly Tek Filter Installed

INITIAL SITE SKETCH

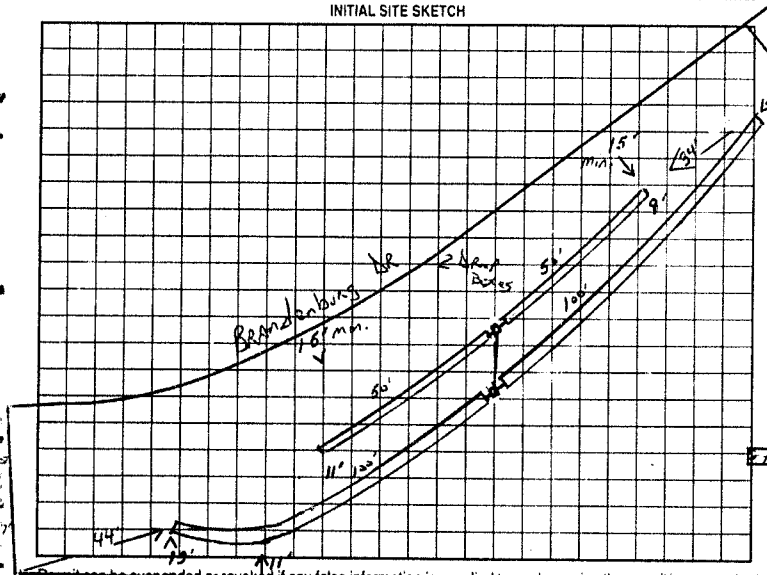


AS BUILT SKETCH

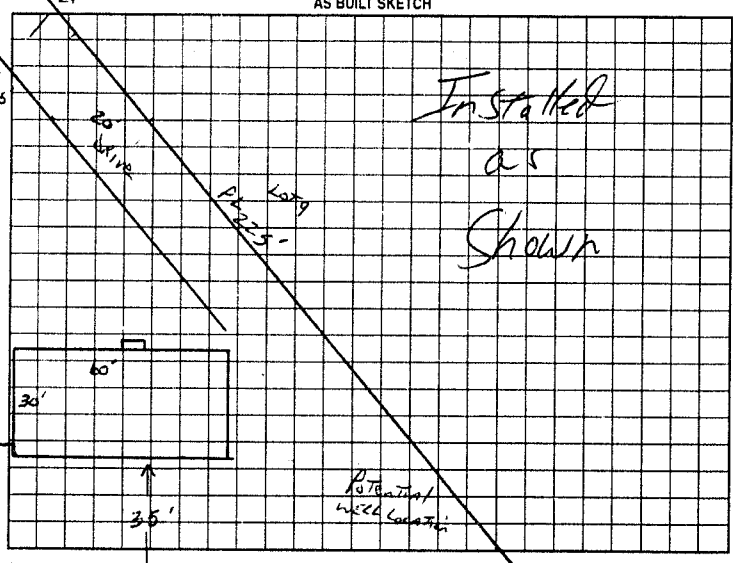


Permit can be suspended or revoked if any false information is supplied toward securing the permit/any unauthorized changes are made to the site/any unauthorized changes are made in the installation of the system. Improvement Permit with plat valid without expiration. Improvement Permit with site plan valid for sixty months. Authorization to Construct is valid for a period equal to that of Improvement Permit – not to exceed sixty months.

Signed: Jon Tolbert date 8/27/99 Installed by: Craig Thompson

Improvement Permit by: J.C. Potter date Aug 23 99 Operation Permit by: William A. Johnson date 6/30/01

Authorization to Construct by: J.C. Potter date Aug 23 99 Existing System Inspection by: date

HEALTH DEPT COPY WHITE OWNER COPY (FINAL) YELLOW OWNER COPY (INITIAL) PINK