IREDELL COUNTY HEALTH DEPARTMENT

STATESVILLE 704-878-5305 MOORESVILLE 704-664-5281

IMPROVEMENT PERMIT / AUTHORIZATION TO CONSTRUCT / OPERATION PERMIT / EXISTING SYSTEM INSPECTION

PERMIT# 82095 PIN# 4722226589 DATE 7-16-99

OWNER OR CONTRACTOR Land Development PHONE: Business 528-6192 Home

ADDRESS Po Box 5602 Statesville

LOCATION Old Mtn Road TL Compton Rt TR Idlebrook TL Brandenburg on left

SUBDIVISION Stonecrest BLOCK / SECTION LOT 6 LOT AREA 1.69 SITE CLASS PS DESIGN FLOW 360 L.T.A.R. .83

Septic Tank: 1000 Gallons: STB 1012 Date 8 22 99

Pump Tank: Gallons; PT Date

Pump Make: Model Serial No.

Nitrification Field: No Fields 1 Square Feet 1200 Linear Feet 400

No Lines 4 Trench Width 36" Max Trench Bottom Depth 36" Gravel Depth 12"

☒ New System ☐ Repair System Type: ☐ II ☐ III ☐ IV ☐ V ☐ VI

System Description: Conv. Gravity

Repair System Description: Gravity 252 Lin. Ft.

Maintenance Agreement Required: ☐ Yes ☒ No

☒ House/Mod. Home No. Bedrooms 3

☐ Mobile Home No. Bathrooms 2

☐ Business No. Employees

☐ Other


☐ Slab ☒ Crawl Space ☐ Basement w/plumbing ☐ Basement wo/plumbing

Water Supply: ☒ Individual ☐ Public ☐ Community


Comments/Conditions:

Comments/Conditions:

INITIAL SITE SKETCH

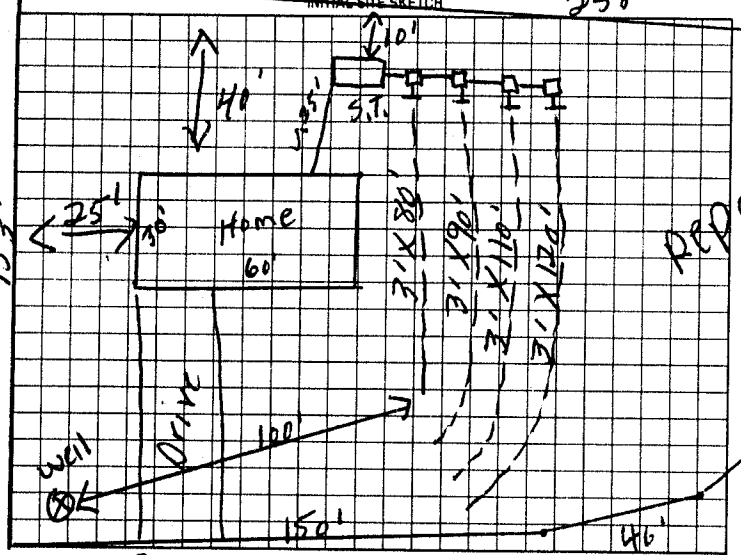

AS BUILT SKETCH

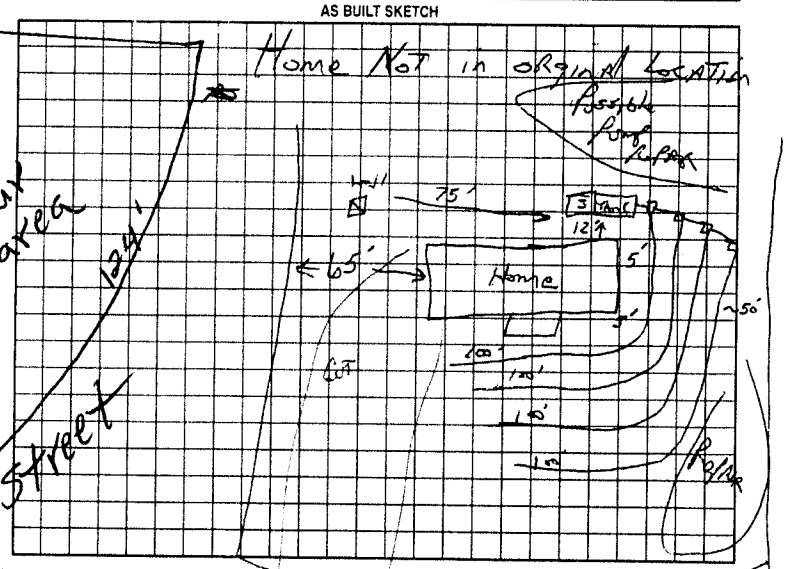

Permit can be suspended or revoked if any false information is supplied toward securing the permit/any unauthorized changes are made to the site/any unauthorized changes are made in the installation of the system. Improvement Permit with plat valid without expiration. Improvement Permit with site plan valid for sixty months. Authorization to Construct is valid for a period equal to that of Improvement Permit – not to exceed sixty months.

Signed: Jon Pot date 7-19-99 Installed by: Young & Son

Improvement Permit by: C. C. Moore date 7-16-99 Operation Permit by: Jon Potter date Nov 9 99

Authorization to Construct by: C. C. Moore date 7-16-99 Existing System Inspection by: date

HEALTH DEPT. COPY WHITE OWNER COPY (FINAL) YELLOW OWNER COPY (INITIAL) PINK