pd. $125

IREDELL COUNTY HEALTH DEPARTMENT

STATESVILLE 704-878-5305 MOORESVILLE 704-664-5281

IMPROVEMENT PERMIT / AUTHORIZATION TO CONSTRUCT / OPERATION PERMIT / EXISTING SYSTEM INSPECTION

PERMIT# 093782 PIN# 4722326905 DATE 3/20/01

~~OWNER OR~~ CONTRACTOR Chris Davidson PHONE: Business (704) 363-2634 Home —

ADDRESS P.O. Box 562 Statesville, N.C. 28687

LOCATION Buffalo Shoals (L) Old Mtn Rd, (R) Compton Park (R) on Idlewood on Left

SUBDIVISION Compton Park BLOCK / SECTION — LOT #10 LOT AREA .46 SITE CLASS PS DESIGN FLOW 360 L.T.A.R. .35 2/14/02

Septic Tank: 1,000 Gallons: STB 1612 Date 1-29-00
Pump Tank: 1,000 Gallons: PT 17 Date 11-1-00
Pump Make: Con-Ser Model 3HP WEDSII/H Serial No 150144101
Nitrification Field: No Fields 1 Square Feet 1039 Linear Feet 262
No Lines 3 Trench Width 36" Max Trench Bottom Depth 30" Gravel Depth —

[X] New System [ ] Repair System Type: I. II (III) IV. V. VI
System Description: 25% Reduction, Pump
Repair System Description: 25% Reduction, Pump
Maintenance Agreement Required: [ ] Yes [ ] No

[X] House/Mod. Home [ ] Mobile Home [ ] Business [ ] Other
No. Bedrooms 3 No. Bathrooms 3 No. Employees —


[ ] Slab [X] Crawl Space [ ] Basement w/plumbing [ ] Basement wo/plumbing

Water Supply: [X] Individual [ ] Public [ ] Community


Comments/Conditions: (1) Install 3 lines 25% Reduction System 42 chambers or HDES section on contour (2) Keep System 10 ft From property lines.

Comments/Conditions: - poly lok fitter - Septic Tank Risers Installed; 42 Infiltrator chambers Installed.

INITIAL SITE SKETCH

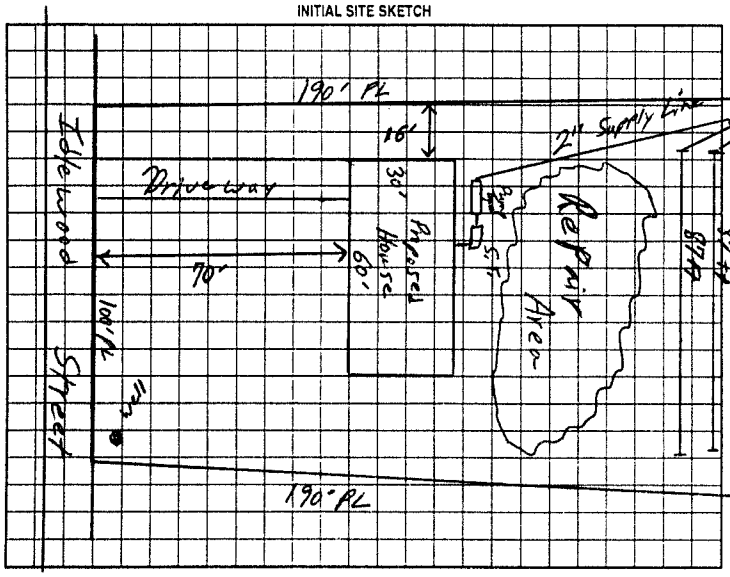

AS BUILT SKETCH

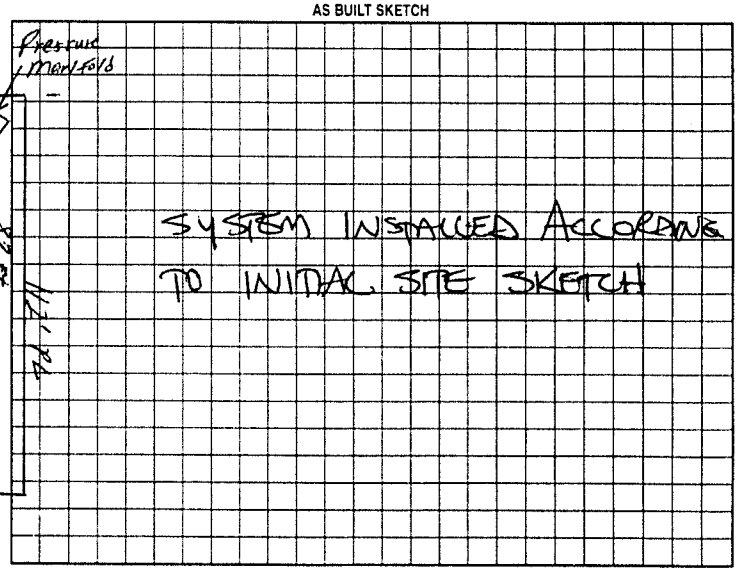

Permit can be suspended or revoked if any false information is supplied toward securing the permit/any unauthorized changes are made to the site/any unauthorized changes are made in the installation of the system. Improvement Permit with plat valid without expiration. Improvement Permit with site plan valid for sixty months. Authorization to Construct is valid for a period equal to that of Improvement Permit – not to exceed sixty months.

Signed: [signature] date 3-21-01 Installed by: David Young

Improvement Permit by: William O. Johnson, RSI date 3/24/01 Operation Permit by: STEVE HEDRICK date 8-10-01

Authorization to Construct by: William O. Johnson, RSI date 3/24/01 Existing System Inspection by: — date —

HEALTH DEPT COPY WHITE OWNER COPY (FINAL) YELLOW OWNER COPY (INITIAL) PINK