HS

ICHD–ENVIRONMENTAL HEALTH DIVISION

Statesville Office (704) 878-5305 | Mooresville Office (704) 660-3625 | PERMIT # AP315516

SEPTIC IMPROVEMENT PERMIT / AUTHORIZATION TO CONSTRUCT / OPERATION PERMIT / EXISTING SYSTEM

PIN # 4722-32-7950 — 7905

APPLICANT/OWNER: Frances and Kelly Pope | APPLICANT ADDRESS: 151 E Tatterstall Dr Statesville NC 28677

SITE ADDRESS: 117 Idlebrook Rd Statesville NC 28677 | PHONE: 631-774-3711 | ALT. PHONE 704-980-4007

SITE DIRECTIONS: West End Ave to L on Buena Vista Ave, R on West Front St, L on Buffalo Shoals Rd, L on Old Mountain Rd, R on Compton Park Rd, R on Idlebrook Rd, L to on L

SAP CONTROLLED: ☐ YES ☒ NO

SUBDIVISION: Compton Park | SECTION: — | LOT # 9 | LOT AREA: 0.45 acres | DESIGN FLOW: Existing | L.T.A.R.: Existing


Septic Tank	1000 (gal)	STB ~~383~~ 760	Date 1-11-2021	☐ New System ☒ Repair ☐ Expansion	System Type: I II III IV V VI	☒ Residence	No. Bedrooms Existing
Pump Tank	— (gal)	PT —	Date —	System Description: New Tank		☐ Business	No. Persons Existing
Pump Make	—	Model —	Serial # —	Repair System Description: Existing		☐ Other	No. Employees —
# Nitrification Fields	EXIST	# Lines	Lineal Ft:	Maintenance Agreement Required: ☐ YES ☒ NO		☐ Slab	☒ Crawl Space
Trench Width		Trench Bottom Depth(Low side) NG	Gravel Depth Existing	☒ GRAVITY ☐ PRESSURE		☐ Basement w/plumbing	☐ Basement w/o plumbing

Water Supply: ☒ Private ☐ Public ☐ Community

Comments / Conditions: Pump crush and remove old ST. If new tank installed at 3' or deeper it must be traffic grade. Reccomend finding DBox and replacing if nessisary

INITIAL SITE SKETCH

1"=40'

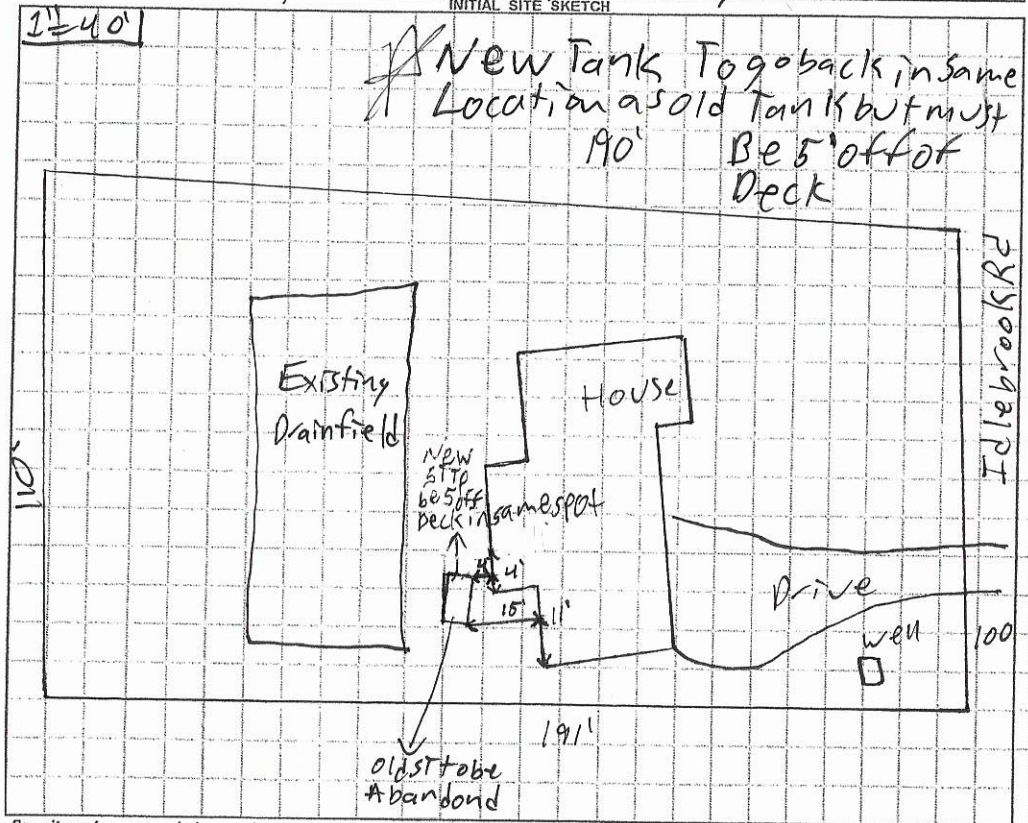

AS BUILT SKETCH

Permit can be suspended or revoked if any false information is supplied toward securing the permit / any unauthorized changes are made to the site / any unauthorized changes are made in the installation of the system. CONTACT A LOCATOR SERVICE PRIOR TO ANY EXCAVATION

☐ IMPROVEMENT PERMIT *with plat valid without expiration.* ☒ IMPROVEMENT PERMIT *with site plan valid for 60 mos.* ☒ AUTHORIZATION TO CONSTRUCT *valid for period equal to IMPROVEMENT PERMIT--not to exceed 60 mo.*

Owner / Applicant Signature: Kelly Pope | Date: 3/11/2021 | Installed by: Lentz Waskowicz

IMPROVEMENT PERMIT by: Patrick J Bagley III | Date: 3/9/2021 | OPERATION PERMIT by: | Date: 3-24-2021

AUTHORIZATION TO CONSTRUCT by: Patrick J Bagley III | Date: 3/9/2021 | Existing System Inspected by: | Date:

FOR SEPTIC FINAL INSPECTION: CALL 704-664-3703 between 8am-9am the day the inspection is needed. Be sure to speak with an inpsector to confirm your inspection time.

APPLICATION MUST BE FILLED OUT COMPLETELY & BE LEGIBLE
OR IT WILL NOT BE PROCESSED

AP-315516
Repair eval.

Iredell County Health Department – Environmental Health Division

PAGE 1: *APPLICATION FORM*

Application For: ( ) New Well Permit ( ) Well Repair Permit ( ) Well Abandonment
( ) Septic Improvement Permit ( ) Authorization to Construct ( ) Existing System Inspection (✓) Septic System Repair

THE ABOVE PERMIT DOCUMENTS WILL BECOME INVALID IF INFORMATION PROVIDED ON THIS APPLICATION IS FALSIFIED OR CHANGED, OR IF THE SITE IS ALTERED. THE IMPROVEMENT PERMIT IS VALID FOR EITHER 60 MONTHS OR WITHOUT EXPIRATION DEPENDING UPON DOCUMENTATION SUBMITTED. APPLICATION WITH SITE PLAN 60 MONTHS, APPLICATION WITH COMPLETE, SCALED PLAT WITHOUT EXPIRATION. SEE 15A NCAC 18A .1937(f) FOR DETAILS.

Page 2: *Site Plan Worksheet* form MUST accompany this application

The following optional attachments may also be submitted: ( ) Survey Plat, scaled no more than 1 inch = 60 feet
Place an (X) beside whichever is submitted if applicable ( ) Custom Site Plan, scaled no more than 1 inch = 60 feet

Applicant Information: (PRINT CLEARLY)

Applicant Name: Francis D. Pope / Kelly Pope Address: 151 E Tattersall Dr. Statesville Zip: 28677
Applicant Email: energetice@aol.com Phone: 631-774-3711 Alt. Phone: 704-980-4007
Owner Name: Four Bs Realty Corp. Address: 151 E. Tattersall Dr. Zip: 28677
Owner Email: _____ Phone: 631 774 3711 Alt. Phone: 704-980-4007

Property Information:

Street Address: 117 Idlebrook Rd Statesville, NC 28677
Subdivision Name: Compton Park Section/Phase: _____ Lot Number: _____
Driving Directions: Old Mountain Rd to Compton Park Rd to Idlebrook Rd.

Site Development Information: *(check or complete ALL that apply*

CHECK FOUNDATION TYPE

( ) New Single Family Residence — Maximum Number of Bedrooms: 3 — (✓) Crawl Space Foundation
( ) New Multi-Family Residence — Maximum Number of Occupants: 5 — ( ) Concrete Slab Foundation
( ) Accessory Building — ( ) Swimming Pool — ( ) Basement with Plumbing
( ) Bedroom(s) Addition — ( ) Other Addition/Structure: _____ — ( ) Basement without Plumbing
( ) Repair to failing septic system ___ Tank ___ Drain lines Describe Problem: _____
Non-Residential Site Development: Type of Business: _____
Square Footage of Building: _____ Max. Number of Employees: _____ Max. Number of Seats/Beds/Other: _____

Water Supply: ( ) Replacement Well – Reason: _____
( ) Multi-connection Well Number of Houses: _____ Number of Persons: _____

( ) New Well ( ) Existing Well ( ) Community Well ( ) City Water ( ) Other Public Water

Desired Septic System Type: *(you may rank in order of preference)* Year existing system installed: _____
( ) No Preference ( ) Alternative (✓) Conventional ( ) Innovative ( ) Modified Conventional ( ) Other: _____

Please answer the following to the best of your ability:

( ) Yes (✓) No Does the site contain any jurisdictional wetlands?
( ) Yes (✓) No Is any non-domestic sewage (i.e. industrial) to be generated?
( ) Yes (✓) No Is the site subject to approval by any other public agency?

I have read this application and certify that the information provided herein is true, complete, and correct. Authorized county and state officials are granted right of entry to conduct necessary inspections to determine compliance with applicable laws and rules. I understand that I am solely responsible for the proper identification and labeling of all property lines and corners and making the site accessible so that a complete site evaluation can be performed.


Signature: Francis D Pope — 3/4/2021
Property owner or owner's legal representative signature (SIGNATURE REQUIRED) DATE

IREDELL COUNTY HEALTH DEPARTMENT

ENVIRONMENTAL HEALTH DIVISION

PAGE 2: *SITE PLAN WORKSHEET*

SEE THE "SAMPLE SITE PLAN" BELOW. *INCOMPLETE SITE PLANS WILL BE RETURNED TO YOU FOR COMPLETION AND MAY RESULT IN A DELAY IN THE ISSUANCE OF YOUR SEPTIC SYSTEM PERMIT!!!*

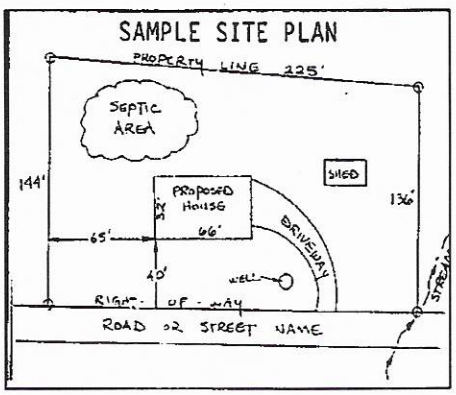

Place an (X) beside each item as you complete the site plan:

- ( ) Property Line measurements are clearly identified
- ( ) All proposed structures are indicated
- ( ) Front and side setbacks from property line
- ( ) Preferred driveway location and well location
- ( ) Area you prefer your septic system to be placed
- ( ) North arrow, or other sufficient indicator of direction

Circle N/A on the following if appropriate:

Location of septic systems and wells within 100' of your property	N/A
Location of easements and rights of ways on your property	N/A
Location of any designated wetlands on the property	N/A

USE THIS SPACE TO DRAW YOUR SITE PLAN

Show: proposed house or business footprint, wells, water lines, patios, pools and decks, and any other item that will occupy space on the site

see attached

Signature: Kelly Pope

Property owner or owner's legal representative signature (SIGNATURE REQUIRED)

3/24/2021

DATE

IREDELL COUNTY HEALTH DEPARTMENT

(SEPTIC TANK) IMPROVEMENTS PERMIT AND CERTIFICATE OF COMPLETION
(Ground Absorption Sewage Disposal System - G. S. Chapter 130-Article 13C)

OWNER OR CONTRACTOR David Martin, Belo DATE 9/22/77 PERMIT NO. _____

PHONE: Business _____ Home _____

LOCATION Compton Park off of old Mountain Rd. S. R. No. _____

SUBDIVISION NAME Compton Park LOT NO. 9 SECTION OR BLOCK NO. _____


House (✓) Mobile Home ( ) Business ( ) Other _____

No. Bedrooms 3 No. Bathrooms 2

Garbage Disposal Unit Yes ( ) No (✓)
Auto. Dishwasher Yes (✓) No ( )
Auto. Wash. Machine Yes (✓) No ( )
Site Suitable Yes (✓) No ( )

Lot Area 20,000 sq ft

Character & Porosity of Soil Cecil Clay
Percolation Rate _____
Topography Slight Slope
Depth to Water Table Low
Rock or other impervious formations None

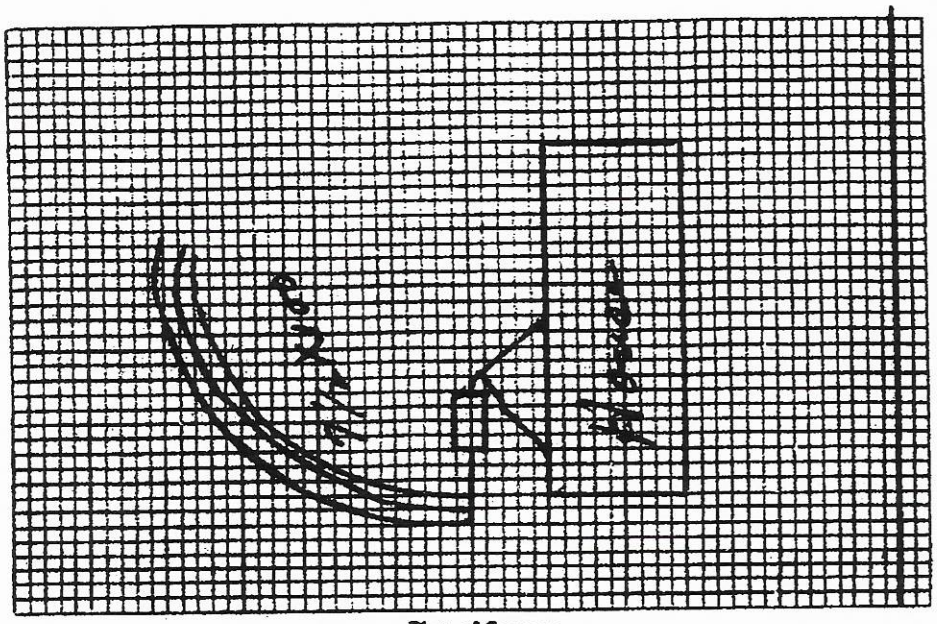

Plot of System

Size of Tank 1250 Gals.
Nitrification Field:
No. of Lines 3
Sq. Ft. 750 Linear Ft. 300
Depth of Stone in Lines 10"
Water Supply: Individual (✓)
Public ( )

Installed by Harlee Lackey

IMPROVEMENTS PERMIT BY _____

COMMENTS: Lines are Level

CERTIFICATE OF COMPLETION BY C. A. Stevenson DATE 9/22/77

CONSTRUCTION MUST COMPLY WITH ALL OTHER APPLICABLE STATE AND LOCAL REGULATIONS.

Health Dept. Copy: White Inspection Dept. Copy: Yellow Sanitarian's Copy: Pink Owner's Copy: Gold

IREDELL COUNTY DEPARTMENT OF ENVIRONMENTAL HEALTH

DOCUMENTATION TO AUTHORIZE AN OWNER'S LEGAL REPRESENTATIVE

(Check and sign only ONE of the options below)

☐ 1. *** APPLICANT AND OWNER ARE THE SAME. *** (*Sign here*) Francis D Pope

Applications for permits require the "signature of the owner or owner's legal representative" (15A NCAC 18A .1937). If the owner does not sign the application himself or herself, they can submit any one of the following documents to designate their legal representative: *Power of Attorney; Real Estate Contract; Estate executor; Bankruptcy trustee; Court ordered guardianship* In the absence of the above documentation, the property owner may provide the local health department with documentation that designates a legal representative. A property owner may:
Complete this form to document his or her legal representative, or provide his or her own form that contains the information in this form. If there are multiple property owners, then all property owners must sign the form that designates a legal representative.
By signing a form that designates a legal representative for purposes of 15A NCAC 18A .1937, the property owner authorizes that representative to act on their behalf in matters pertaining to the application and permitting process, including signing or receiving any application, document or permit. The owner retains full responsibility to meet all permit conditions specified by the local health department.

☐ 2. I, Francis D Pope, am the legal owner(s) of the property located at 117 Idlebrook Rd, identified as PIN (Parcel Identification Number) [redacted] 4722321905, located in Iredell County, North Carolina.

I do hereby authorize (**print legal representative/company name**) _____, _____, to act as an agent on my behalf in applying for/signing/obtaining any of the documents described below.

- Application for Improvement Permit (IP) / Authorization to Construct (AC)
- Improvement Permit (IP) / Authorization to Construct (AC)
- Application for soil-site evaluation (new/repair)
- Application/permit for private drinking water well/well abandonment
- Application for Compliance Inspection

I agree to abide by all decisions and/or conditions between the legal representative acting on my behalf and the Iredell County Department of Public Health, Environmental Health Division.

Francis D Pope
Signature of Owner(s)

3/4/2021
Date

Mooresville - Environmental Health
Fax: 704-662-3239
610 E. Center Avenue, Mooresville, NC 28115

Statesville - Environmental Health
ronda.hart@co.iredell.nc.us
Fax: 704-871-3483
349 N. Center Street, Statesville, NC 28677