IREDELL COUNTY HEALTH DEPARTMENT

STATESVILLE 704-878-5305 MOORESVILLE 704-664-5281

IMPROVEMENT PERMIT / AUTHORIZATION TO CONSTRUCT / OPERATION PERMIT / EXISTING SYSTEM INSPECTION

PERMIT# 82090 PIN# 4722226589 DATE 7-1-99

OWNER OR CONTRACTOR Land Development Services PHONE: Business 5286192 Home

ADDRESS PO Box 5602 Statesville, N.C.

LOCATION Old Mtn Rd Turn Compton Park TR Idle bk To Brandenburg 1st on Rt

SUBDIVISION StoneCrest BLOCK / SECTION LOT 1 LOT AREA .57acres SITE CLASS PS DESIGN FLOW 360 L.T.A.R. .3

Septic Tank: 1000 Gallons: STB 1012 Date 8/2/99
Pump Tank: Gallons: PT Date
Pump Make: Model Serial No.
Nitrification Field: No Fields 1 Square Feet 900 Linear Feet 300
No Lines 3 Trench Width 36" Max Trench Bottom Depth 36" Gravel Depth N/A

☑ New System ☐ Repair System Type: I, II, III, IV, V, VI
System Description: Gravity 1520 Rec.
Repair System Description:
Maintenance Agreement Required: ☐ Yes ☑ No

☑ House/Mod. Home No. Bedrooms 3
☐ Mobile Home No. Bathrooms 2
☐ Business No. Employees
☐ Other
☐ Slab ☑ Crawl Space ☐ Basement w/plumbing ☐ Basement wo/plumbing


Water Supply: ☑ Individual ☐ Public ☐ Community

Comments/Conditions:

161'

Comments/Conditions:

INITIAL SITE SKETCH

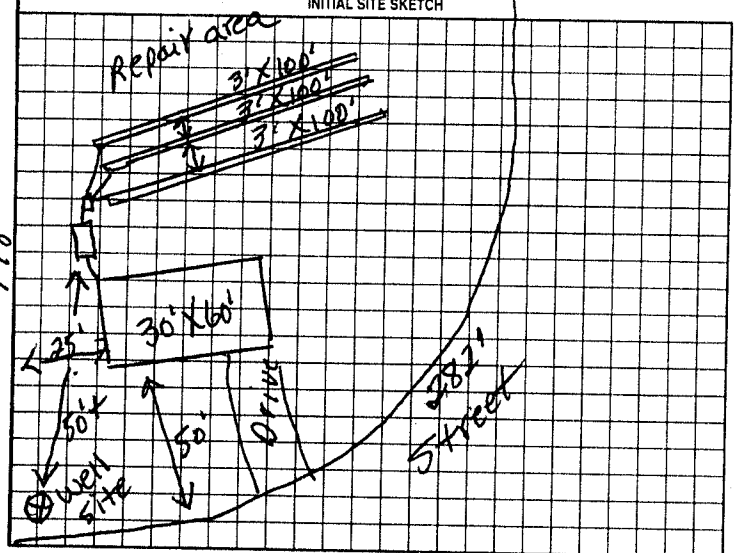

AS BUILT SKETCH

Installed As Shown

Permit can be suspended or revoked if any false information is supplied toward securing the permit/any unauthorized changes are made to the site/any unauthorized changes are made in the installation of the system. Improvement Permit with plat valid without expiration. Improvement Permit with site plan valid for sixty months. Authorization to Construct is valid for a period equal to that of Improvement Permit – not to exceed sixty months.

Signed: Jon Fol date 7-8-99

Improvement Permit by: P.C. Moore date 7-1-99

Authorization to Construct by: P.C. Moore date 7-1-99

Installed by: Al Backhoe

Operation Permit by: Jc Potter date Oct 29 99

Existing System Inspection by: date

HEALTH DEPT. COPY WHITE OWNER COPY (FINAL) YELLOW OWNER COPY (INITIAL) PINK