IREDELL COUNTY HEALTH DEPARTMENT

Statesville Office (704) 878-5305 Mooresville Office (704) 660-3625 PERMIT # 180266

IMPROVEMENT PERMIT / AUTHORIZATION TO CONSTRUCT / OPERATION PERMIT / EXISTING SYSTEM

PIN # 4722389209

APPLICANT: Maria Call APPLICANT ADDRESS: 268 Compton Park

SITE ADDRESS: 268 Compton Park PHONE: 704-657-8100 ALT. PHONE: N/A

SITE DIRECTIONS: Buffalo Shoals Rd TL Old Mtn Rd. TR Compton Park

SUBDIVISION: Compton Park SECTION: N/A LOT # 38 LOT AREA: 0.63 DESIGN FLOW: 360gpd L.T.A.R.: Existing


Septic Tank	Existing (gal)	STB		Date		☐ New System ☐ Repair ☐ Expansion	System Type: I (II) III IV V VI	☑ Residence	No. Bedrooms	3	Water Supply
Pump Tank	(gal)	PT		Date		System Description:	Conventional	☐ Business	No. Persons		☑ Private
Pump Make		Model		Serial #		Repair System Description:		☐ Other	No. Employees		☐ Public
# Nitrification Fields	Ex	# Lines	Ex	Linear Ft:	Ex	Maintenance Agreement Required:	☐ YES ☑ NO	☑ Slab	☑ Crawl Space		☐ Community
Trench Width	Ex	Max. Trench Bottom Depth	Ex	Gravel Depth	Ex	☑ GRAVITY	☐ PRESSURE	☐ Basement w/plumbing		☐ Basement w/o plumbing	

Comments / Conditions:

- Maintain a minimum of 5' between accessory building foundation & all components of septic tank system.

INITIAL SITE SKETCH

AS BUILT SKETCH

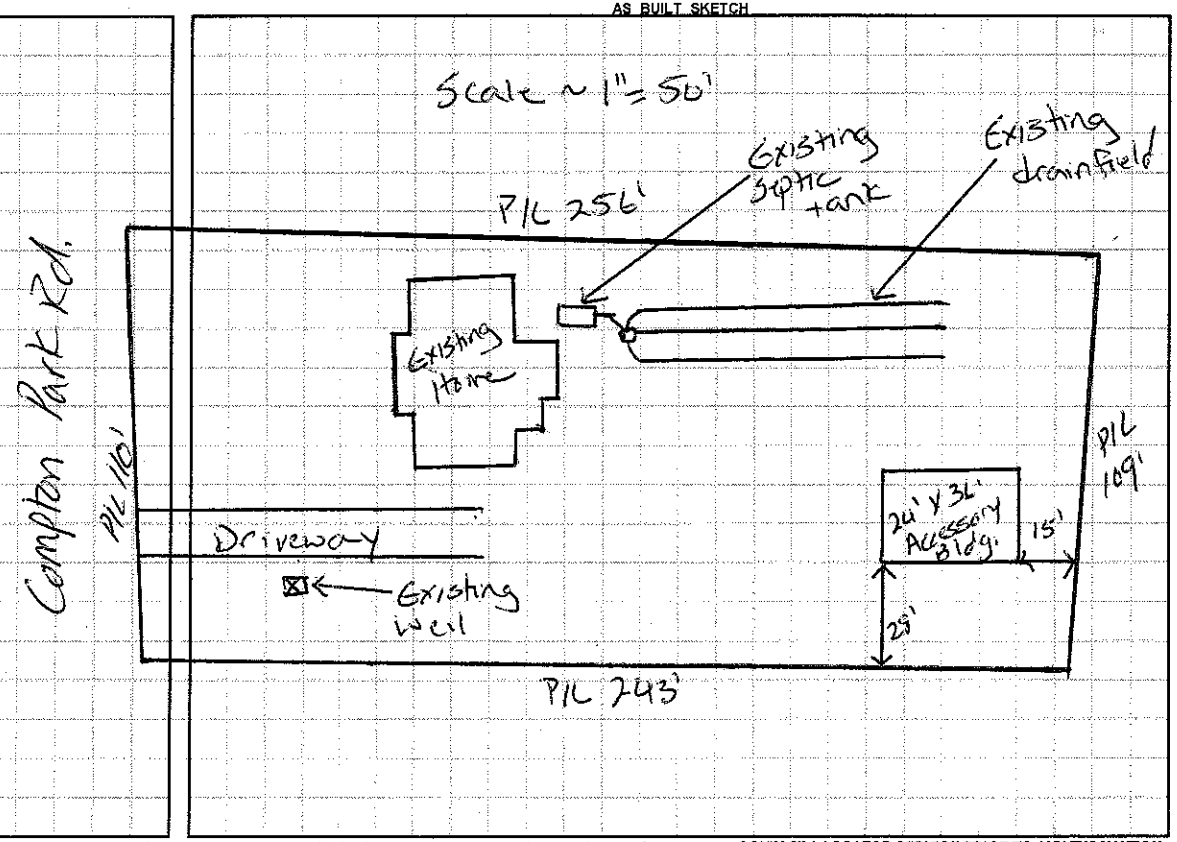

Permit can be suspended or revoked if any false information is supplied toward securing the permit / any unauthorized changes are made to the site / any unauthorized changes are made in the installation of the system. **CONTACT A LOCATOR SERVICE PRIOR TO ANY EXCAVATION**

☐ **IMPROVEMENT PERMIT** *with plat valid without expiration.* ☐ **IMPROVEMENT PERMIT** *with site plan valid for 60 mos.* ☐ **AUTHORIZATION TO CONSTRUCT** *valid for period equal to IMPROVEMENT PERMIT--not to exceed 60 mo.*

Owner / Applicant Signature: Maria B. Call Date: 8-16-13 Installed by:

IMPROVEMENT PERMIT by: Date: OPERATION PERMIT by: Date:

AUTHORIZATION TO CONSTRUCT by: Date: Existing System Inspected by: Martha Henderson Date: 8-16-13

Health Dept. Copy - WHITE Applicant (Final Approval) - YELLOW Applicant (Conditional Approval) - PINK