IREDELL COUNTY HEALTH DEPARTMENT

Statesville Phone TR 3-7271 Mooresville Phone NO 3-1271

PERMIT TO INSTALL SEPTIC TANK

Permit No. 3 Permit Date 6-14 19 71

Owner John Gilbert Perry Address Statesville Rt. 10

Installed By Lacky Brothers Address Stony Point


Location of Property Kyles Cross Road go towards Troutman on old Mountain Road to first Dirt Road Turn Right last Trailer House on Left

Tank		Capacity		Length of Lines		Fixtures	
Block	( )	1000	(✓)	225'	(✓)	No. of Baths	(1)
Precast	(✓)	1250	( )	250'	( )	Dishwasher	( )
		1500	( )	Other		Garbage Grdr.	( )
		Other				Other	

NOTIFY HEALTH DEPARTMENT AT LEAST EIGHT HOURS BEFORE TANK IS TO BE INSPECTED.

Final Inspection 19 Approved ( ) Disapproved ( )

Remarks

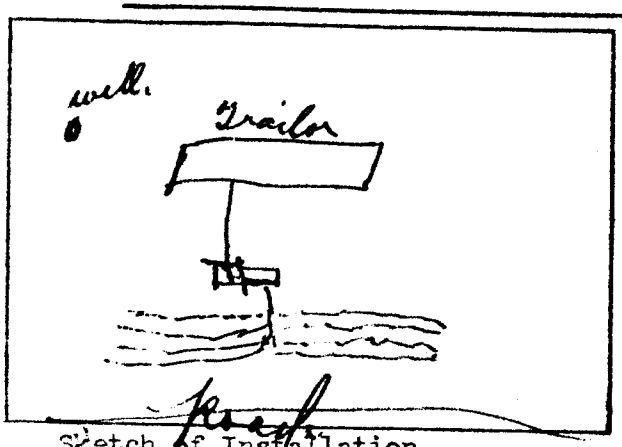

Sketch of Installation

C. S. H.

Sanitarian