IREDELL COUNTY HEALTH DEPARTMENT

STATESVILLE 704-878-5305 MOORESVILLE 704-664-5281

IMPROVEMENT PERMIT / AUTHORIZATION TO CONSTRUCT / OPERATION PERMIT / EXISTING SYSTEM INSPECTION

PERMIT# 124332 PIN# 4722-36-5803 DATE 10-27-04

OWNER OR CONTRACTOR DAVID HYKES PHONE: Business 704-528-7960 Home 704-902-7773

ADDRESS 1042 CHARLOTTE Hwy, TROUTMAN NC 28166

LOCATION I-40 W, TL OLD MOUNTAIN RD, TR ORVILLE LANE, LOT ON LEFT AT WRIGHT LANE

SUBDIVISION _____ BLOCK / SECTION _____ LOT _____ LOT AREA 1.0 ACRE SITE CLASS. PS DESIGN FLOW 480 L.T.A.R. 0.30 GPD/FT²

Septic Tank: EXISTING Gallons; STB _____ Date _____

Pump Tank: _____ Gallons; PT _____ Date _____

Pump Make: _____ Model _____ Serial No. _____

Nitrification Field: No Fields 1 Square Feet 600 Linear Feet 200

No Lines TWO Trench Width 36" Max Trench Bottom Depth 36" Gravel Depth 12"

☑ New System ☐ Repair System Type: I, (II), III, IV, V, VI

System Description: CONVENTIONAL, GRAVITY

Repair System Description: 50% REDUCTION, PUMP

Maintenance Agreement Required: ☐ Yes ☑ No

☑ House/Mod. Home No. Bedrooms 4

☐ Mobile Home No. Bathrooms _____

☐ Business No. Employees _____

☐ Other _____


☐ Slab ☑ Crawl Space ☐ Basement w/plumbing ☐ Basement wo/plumbing

Water Supply: ☑ Individual ☐ Public ☐ Community WELL

Comments:/Conditions: INTERSECT EXISTING DRAINLINE WITH NEW DROP BOX SET HIGH TO SERIALLY NEW TWO NEW DRAINLINES AS SHOWN.

Comments:/Conditions:

INITIAL SITE SKETCH ~SCALE: 1"=60'

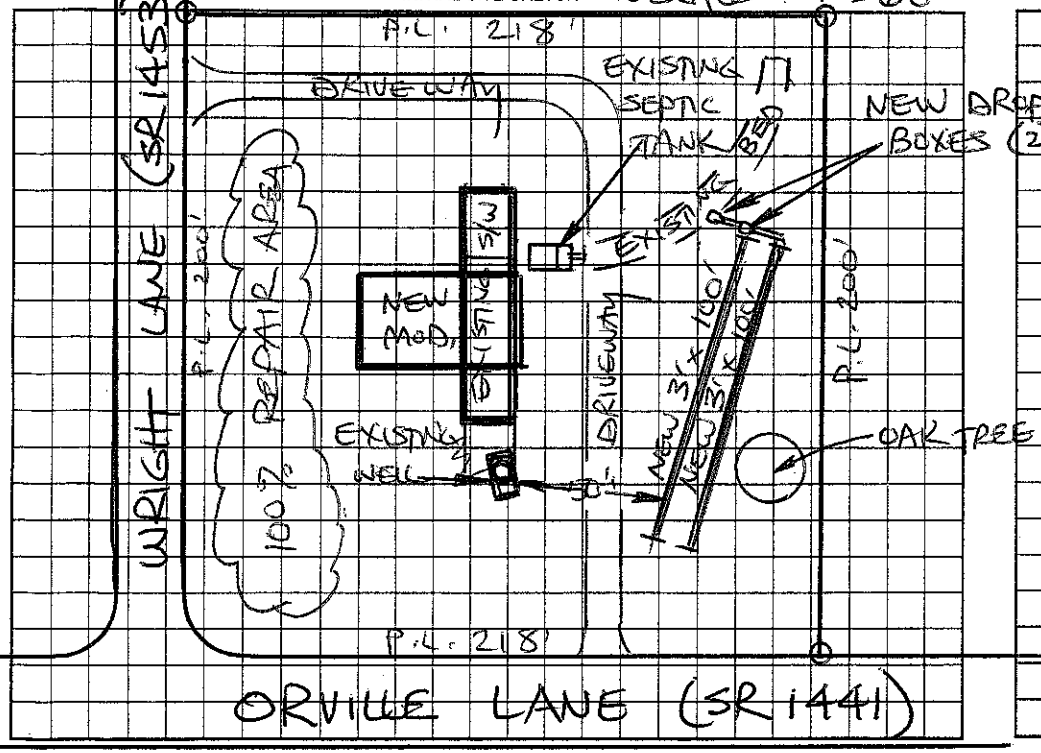

AS BUILT SKETCH

SYSTEM EXPANDED ACCORDING TO INITAL SITE SKETCH

Permit can be suspended or revoked if any false information is supplied toward securing the permit/any unauthorized changes are made to the site/any unauthorized changes are made in the installation of the system. Improvement Permit with plat valid without expiration. Improvement Permit with site plan valid for sixty months. Authorization to Construct is valid for a period equal to that of Improvement Permit – not to exceed sixty months.

Signed: Dennis Gallehue date 10-28-04 Installed by: A-1 BACKHOE

Improvement Permit by: STEVE HEDRICK date 10-27-04 Operation Permit by: STEVE HEDRICK date 11-8-04

Authorization to Construct by: STEVE HEDRICK date 10-27-04 Existing System Inspection by: _____ date _____

HEALTH DEPT. COPY: WHITE OWNER COPY (FINAL): YELLOW OWNER COPY (INITIAL): PINK