871-3483

IREDELL COUNTY HEALTH DEPARTMENT

STATESVILLE 704-878-5305 MOORESVILLE 704-664-5281

IMPROVEMENT PERMIT / CERTIFICATE OF COMPLETION / OPERATION PERMIT / EXISTING SYSTEM INSPECTION

PROPERTY DESCRIPTION NO. 069160 DATE Sept 2 1997 TAX MAP NO. 4722 565 803 Watershed: ☐ Yes ☐ No

OWNER OR CONTRACTOR Shannon Jordan PHONE: Business ______ Home ______ WS-IV-A

ADDRESS 352 Winecoff Rd Mooresville NC 28115

LOCATION I-40 W Turnersburg Rd Troutman on corner of Orville + Wright Ln

SUBDIVISION ______ BLOCK / SECTION ______ LOT ______ LOT AREA ______ SITE CLASS. ______ DESIGN FLOW 360 L.T.A.R. ______

Septic Tank: 1000 Gallons; STB ______ Date ______

Pump Tank: ______ Gallons; PT ______ Date ______

Pump Make: ______ Model ______ Serial No. ______

Nitrification Field: No Fields ______ Square Feet ______ Linear Feet ______

No Lines ______ Trench Width ______ Max Trench Bottom Depth ______ Gravel Depth ______

☐ New System ☐ Repair System Type: I, II, III, IV, V, VI

System Description: ______

Repair System Description: ______

Maintenance Agreement Required: ☐ Yes ☐ No

☐ House/Mod. Home No. Bedrooms 3

☑ Mobile Home No. Bathrooms 2

☐ Business No. Employees ______

☐ Other ______

☐ Slab ☐ Crawl Space ☐ Basement w/plumbing ☐ Basement wo/plumbing


Water Supply: ☑ Individual ☐ Community ☐ Public

Comments:

Comments:

INITIAL SITE SKETCH

AS BUILT SKETCH

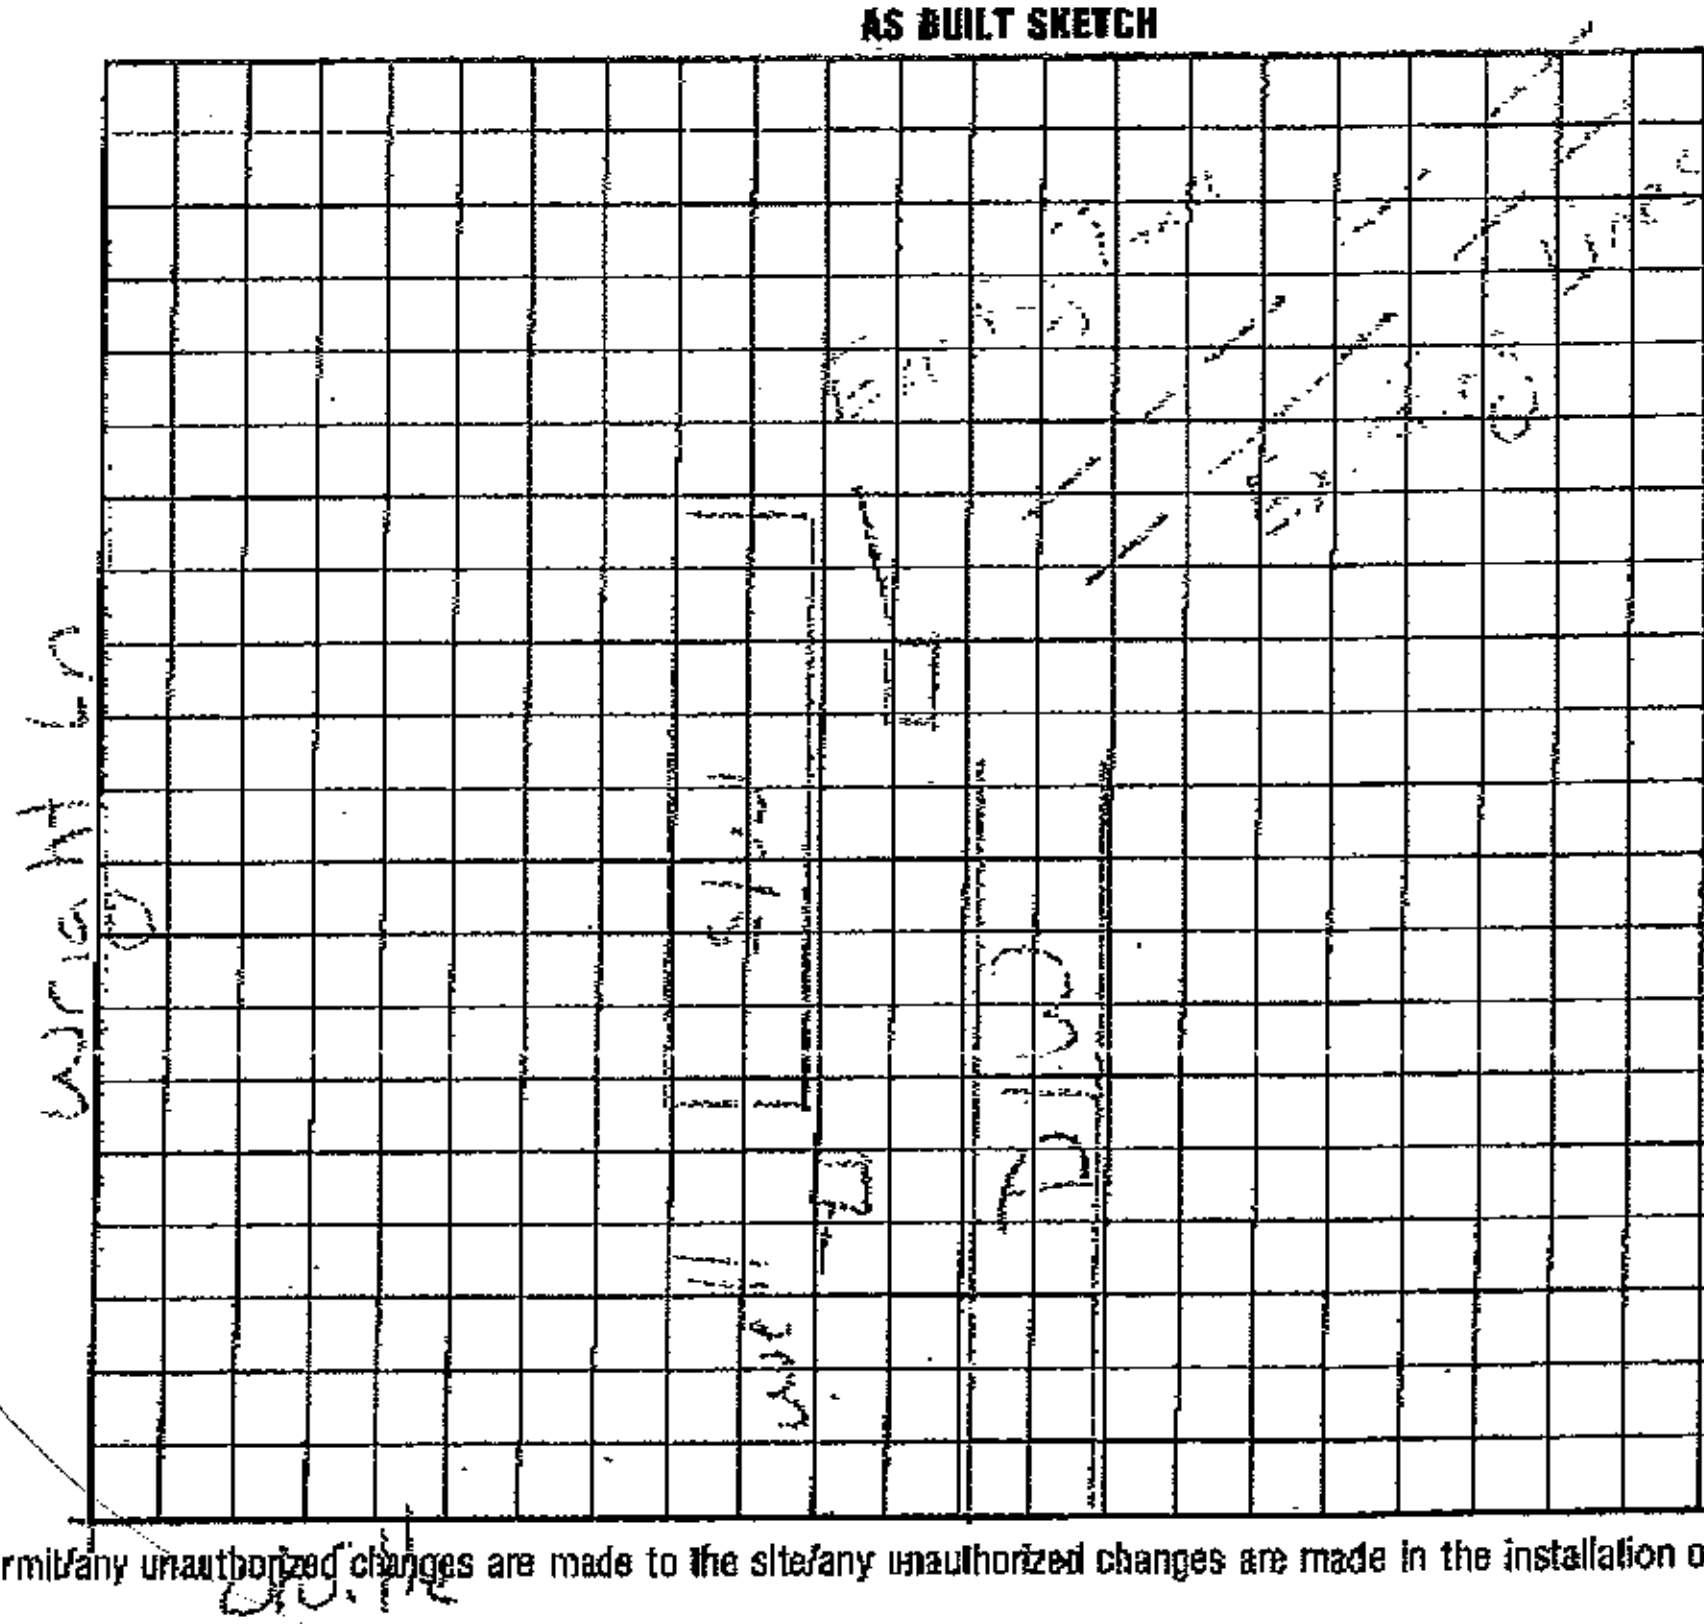

I understand that this permit can be suspended or revoked if any false information is supplied toward securing the permit/any unauthorized changes are made to the site/any unauthorized changes are made in the installation of the system. Improvement Permit is valid for 60 months from date of issuance.

Signed: [signature]

Improvement Permit by: ______ date ______

Existing System Inspection by: [signature] RS date 9-2-97

Installed by: ______

Certificate of Completion by: ______ date ______

Operation Permit by: ______ date ______

HEALTH DEPT. COPY: WHITE INSPECTION COPY (FINAL): GREEN OWNER COPY (FINAL): YELLOW INSPECTION COPY (INITIAL): PINK OWNER COPY (INITIAL): GOLD