# IREDELL COUNTY HEALTH DEPARTMENT

STATESVILLE 704-878-5305 MOORESVILLE 704-664-5281

## IMPROVEMENT PERMIT / AUTHORIZATION TO CONSTRUCT / OPERATION PERMIT / EXISTING SYSTEM INSPECTION

PERMIT # 161742 PIN # 4722-37-0833 0922 DATE July 13 2010

OWNER or APPLICANT CHRIS JOHNSON PHONE: Business Home: 704-775-8911

OWNER or APPLICANT ADDRESS 214 E. ENA AVE STATESVILLE NC 28677

LOCATION / DIRECTIONS BUFFALO SHOALS ROAD SW, ON LEFT JUST PAST OLD MOUNTAIN ROAD

SUBDIVISION BLOCK / SECTION LOT # ~~0.316AC~~ LOT AREA 0.316Ac DESIGN FLOW 384 L.T.A.R. 0.3 (0.25 F.S.R.)

Septic Tank 1000 Gallons: STB -794 Date 3-29-10

Pump Tank 750 Gallons: GT DP1000 Date 3-16-07

GREASE TRAP Manufacturer Model Serial #

Nitrification Field No Fields 1 No Lines 4 Linear Feet 488'

Trench Width 36" Max. Trench Bottom Depth 36" Gravel Depth N/A

☑ New System ☐ Repair ☐ Expansion System Type I II (III) IV V VI

System Description: 25% REDUCTION GRAVITY

Repair System Description: 25% REDUCTION, pump/GRAVITY

Maintenance Agreement Required ☐ YES ☑ NO

☑ GRAVITY ☐ PRESSURE

☐ Residence No. Bedrooms

☑ Business No. Persons 1

☐ Other No. Employees

☐ Slab ☐ Crawl Space


☐ Basement w/plumbing ☐ Basement w/o plumbing

Water Supply: ☐ Private ☑ Public ☐ Community


Comments / Conditions (1) INSTALL 25% REDUCTION SYSTEM (NO RED. GIVEN FOR FOOD STAND FLOOR SPACE) (2) KEEP SYSTEM MINIMUM 50' FROM PRIVATE WELLS 25' FROM SURFACE DIVERSION DITCH (3) NECESSARY EASEMENTS SHALL BE OBTAINED PRIOR TO ISSUANCE OF O.P.

Comments / Conditions (4) THE GREASE TRAP SHALL BE PLUMBED TO RECEIVE ALL WASTES ASSOCIATED WITH FOOD HANDLING AND NO TOILET WASTES.

INITIAL SITE SKETCH

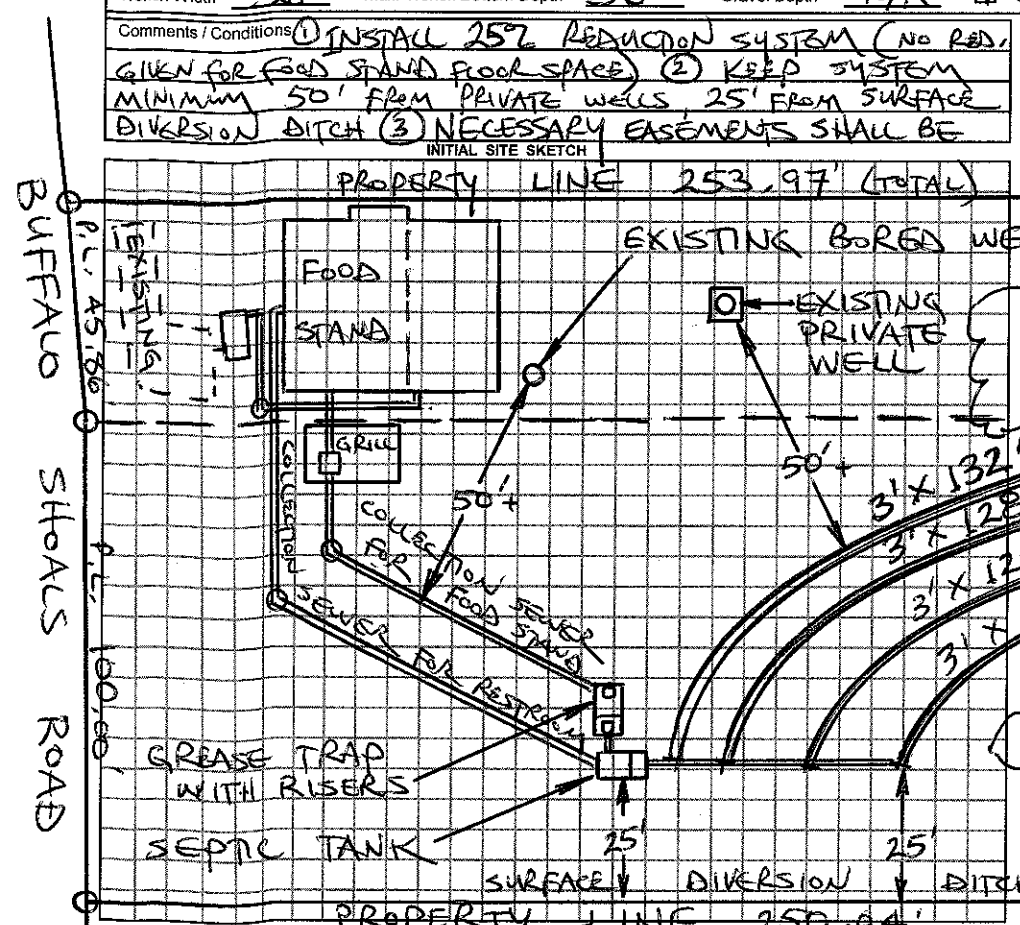


AS BUILT SKETCH

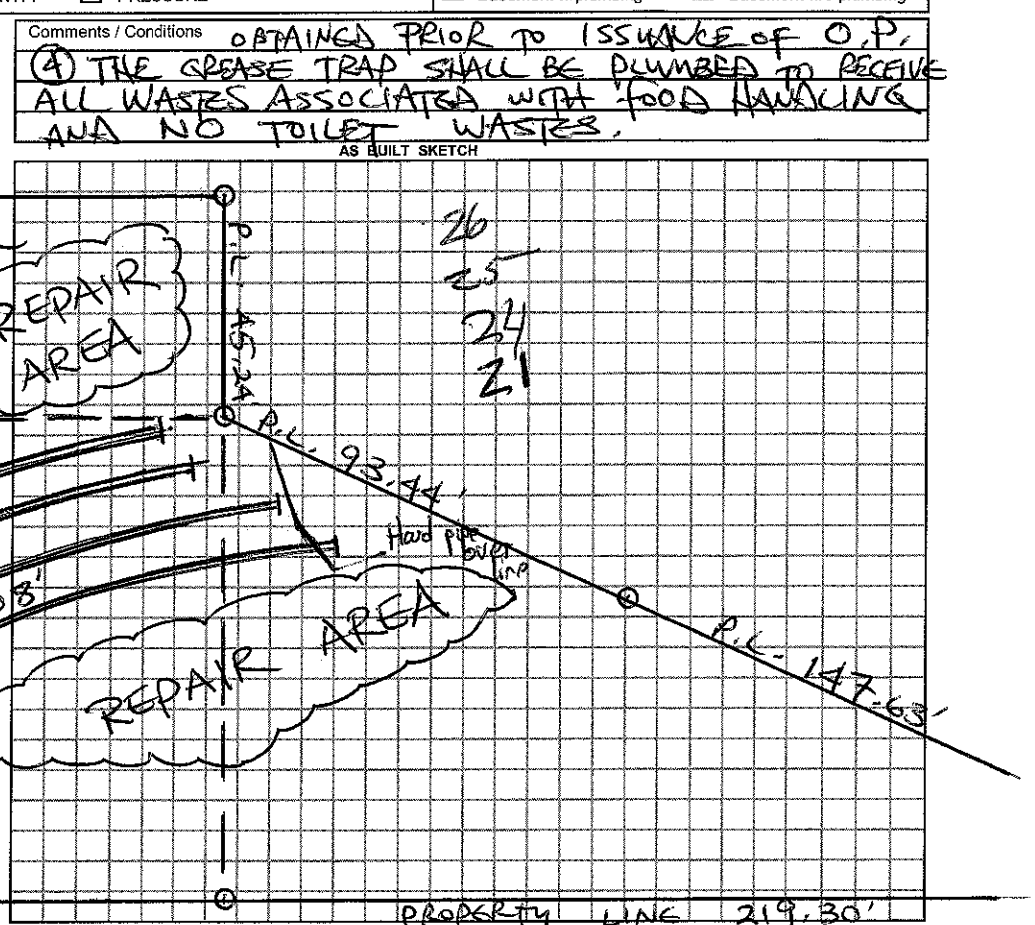


*Permit can be suspended or revoked if any false information is supplied toward securing the permit / any unauthorized changes are made to the site / any unauthorized changes are made in the installation of the system.*

☐ *IMPROVEMENT PERMIT w / plat valid without expiration.* ☐ *IMPROVEMENT PERMIT w / site plan valid for 60 mos.* ☐ *AUTHORIZATION TO CONSTRUCT valid for period equal to IMPROVEMENT PERMIT-not to exceed 60 mo.*

Applicant Signature: Date 7-15-10

Permit by: STEVE HEDRICK Date 7-13-2010

Construct by: STEVE HEDRICK Date 8-2-2010

Installed by: ~~Craig Thompson~~ / Tommy Frye Date: 8-5-10

Operation Permit by: Date:

Existing System Inspected by: Date:

***BUILD CONTACT A LOCATOR SERVICE PRIOR TO ANY EXCAVATION.***

WHITE COPY Environmental Health YELLOW COPY (Final) Owner / Applicant PINK COPY (Initial) Owner / Applicant