IREDELL COUNTY HEALTH DEPARTMENT

IMPROVEMENT PERMIT / CERTIFICATE OF COMPLETION / OPERATION PERMIT / EXISTING SYSTEM INSPECTION

STATESVILLE 704-878-5305 MOORESVILLE 704-664-5281

PROPERTY DESCRIPTION NO. 2-5477 d9299 DATE 11-13-96 TAX MAP NO. 35-3-J-1B

OWNER OR CONTRACTOR Bryan Bennett PHONE: Business Home 528-3159

ADDRESS 117 Sherrill Ct. Troutman N.C. Watershed: ☑ Yes ☐ No

LOCATION Old Mtn Rd TL Orville RJ TR Wright Rd (new RJ) at end left. USIC-PA

SUBDIVISION BLOCK / SECTION LOT LOT AREA SITE CLASS 1.25 DESIGN FLOW 360 L.T.A.R. .13

Septic Tank: 1000 Gallons; STB 786 Date 8-9-96 ☑ New System ☐ Repair System Type: I, II, III, IV, V, VI

Pump Tank: Gallons; PT Date System Description: Conv. Gravity

Pump Make: Model Serial No. Repair System Description:

Nitrification Field: No Fields 1 Square Feet 1200 Linear Feet 400 Maintenance Agreement Required: ☐ Yes ☑ No

No Lines 3 Trench Width 36" Max Trench Bottom Depth 36" Gravel Depth 12"

☑ House/Mod. Home ☐ Mobile Home ☐ Business ☐ Other

No. Bedrooms 3 No. Bathrooms 2 No. Employees

☐ Slab ☐ Crawl Space ☑ Basement w/plumbing ☐ Basement wo/plumbing


Water Supply: ☑ Individual ☐ Community ☐ Public

Comments:

Well next door


288'

INITIAL SITE SKETCH

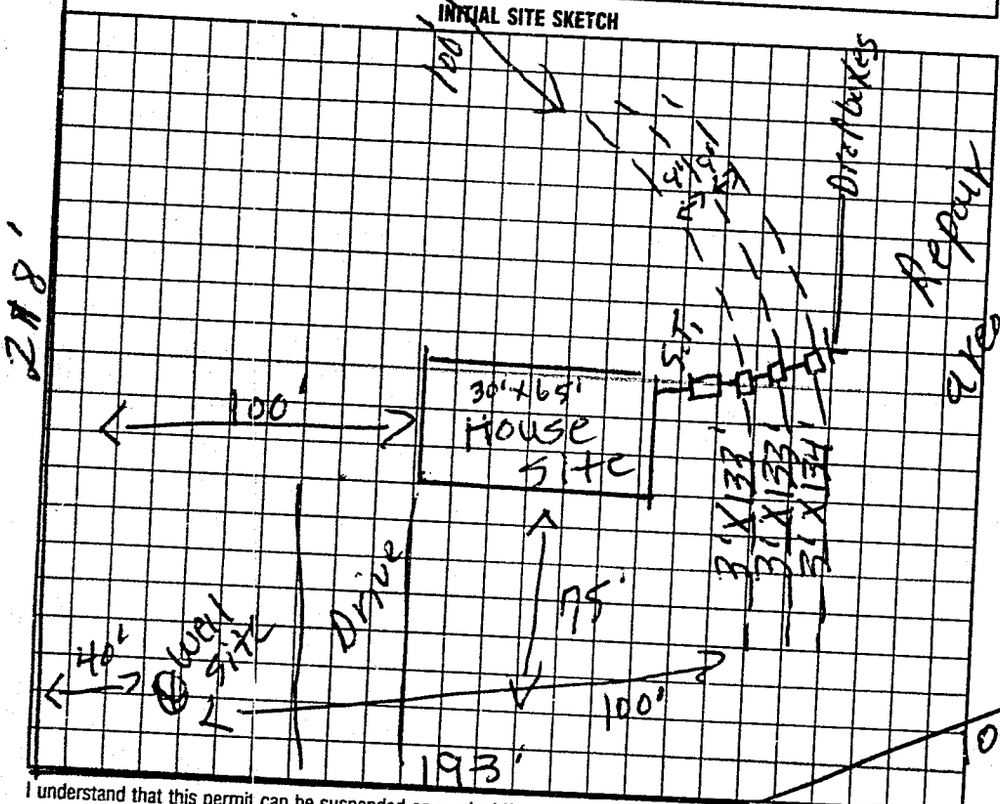

Comments:

AS BUILT SKETCH

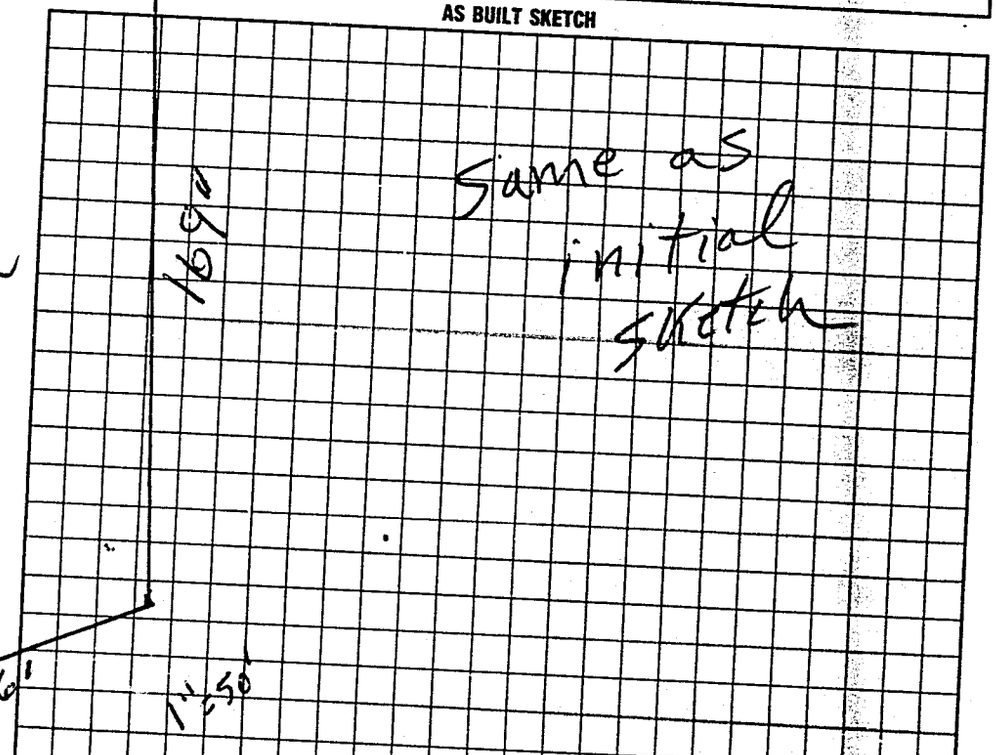

I understand that this permit can be suspended or revoked if any false information is supplied toward securing the permit/any unauthorized changes are made to the site/any unauthorized changes are made in the installation of the system.

Signed: J. E. Brawley Wright Rd

Improvement Permit by: L.C. Moore date 11-13-96

Existing System Inspection authorization L.C. Moore date 11-13-96

to Const.

Installed by: Larry Reep (Lincoln Co)

Certificate of Completion by: date

Operation Permit by: L.C. Moore date 11-13-98

HEALTH DEPT. COPY: WHITE INSPECTION COPY (FINAL): GREEN OWNER COPY (FINAL): YELLOW INSPECTION COPY (INITIAL): PINK OWNER COPY (INITIAL): GOLD

Authorization to Const. Expires 6 months from issue.