pd. 125 (JP)

IREDELL COUNTY HEALTH DEPARTMENT

STATESVILLE 704-878-5305 MOORESVILLE 704-664-5281

IMPROVEMENT PERMIT / AUTHORIZATION TO CONSTRUCT / OPERATION PERMIT / EXISTING SYSTEM INSPECTION

DATE 2/26/01

PERMIT# 094426 PIN# 4722 37 3451

OWNER OR CONTRACTOR TRIVESTER INC. PHONE: Business (704) 609-7745 Home

ADDRESS P.O. BOX 115, MOORESVILLE, NC 28115

LOCATION BUFFALO SHOALS RD. (L) OLD MTN. RD. (R) ORVILLE RD. 1ST GRAVEL RD. TO (R) (WRIGHT LN.)

SUBDIVISION TROUTMAN AF BLOCK / SECTION LOT 114 LOT AREA .5 SITE CLASS PS DESIGN FLOW 360 GPD L.T.A.R. .30

Septic Tank: 1000 Gallons: STB Date

Pump Tank: Gallons: PT Date

Pump Make: Model Serial No.

Nitrification Field: No Fields 1 Square Feet 900 Linear Feet 300'

No Lines 4 Trench Width 3' Max Trench Bottom Depth 30" Gravel Depth

(X) New System ( ) Repair System Type: I. II (III) IV. V. VI

System Description: 25% REDUCTION

Repair System Description: 50% REDUCTION

Maintenance Agreement Required: ( ) Yes (X) No

( ) House/Mod. Home No. Bedrooms 3

(X) Mobile Home No. Bathrooms 2

( ) Business No. Employees

( ) Other


( ) Slab (X) Crawl Space ( ) Basement w/plumbing ( ) Basement wo/plumbing

Water Supply: (X) Individual ( ) Public ( ) Community


Comments/Conditions: (1) NO CUTTING OR FELLING OVER DRAINFIELD/REPAIR AREAS (2) KEEP ALL DRAINS AWAY FROM DRAINFIELD/REPAIR AREAS (3) MAINTAIN SETBACKS (4) INSTALL DRAINLINES UNIFORM AND ON CONTOUR

Comments/Conditions — E Zee Lay System Installed
— Zabel Filter Installed

INITIAL SITE SKETCH

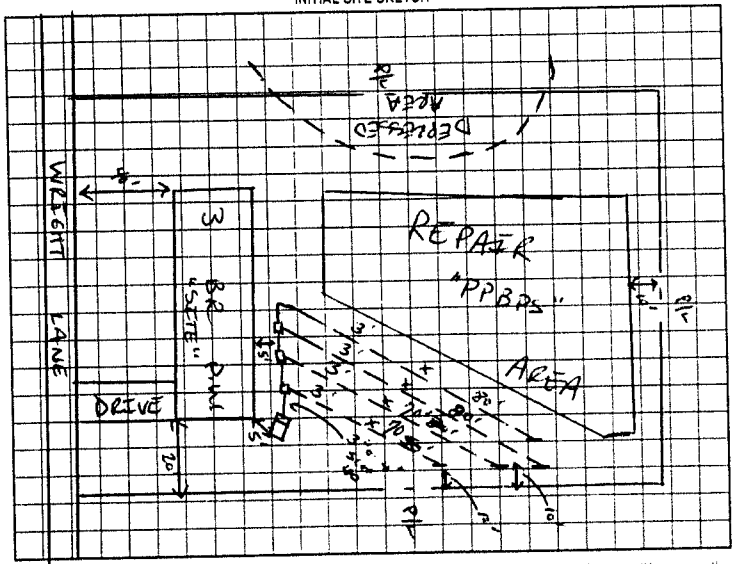

AS BUILT SKETCH Not to Scale

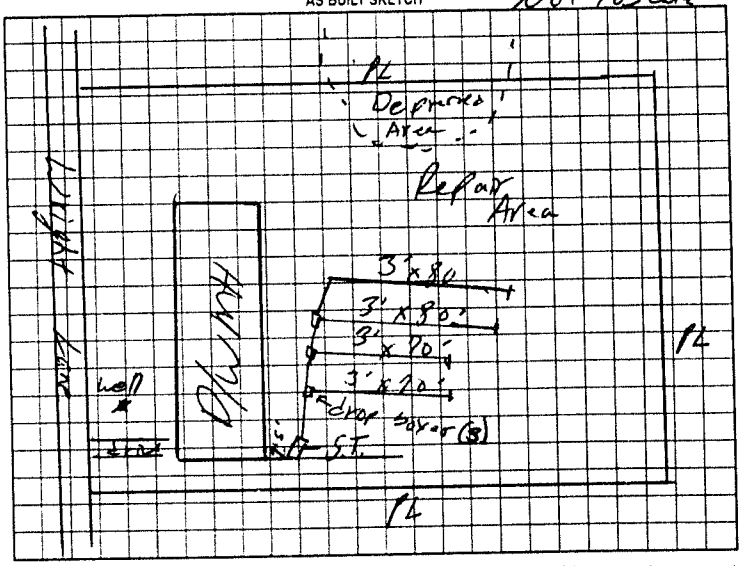

Permit can be suspended or revoked if any false information is supplied toward securing the permit/any unauthorized changes are made to the site/any unauthorized changes are made in the installation of the system. Improvement Permit with plat valid without expiration. Improvement Permit with site plan valid for sixty months. Authorization to Construct is valid for a period equal to that of Improvement Permit – not to exceed sixty months.

Signed: RM Pell date

Improvement Permit by: Judy Shinn date 2/26/01

Authorization to Construct by: Judy Shinn date 2/26/01

Installed by: Craig Thompson

Operation Permit by: William G. Johnson date 6/9/01

Existing System Inspection by: date

HEALTH DEPT COPY WHITE OWNER COPY (FINAL) YELLOW OWNER COPY (INITIAL) PINK