IREDELL COUNTY HEALTH DEPARTMENT

Statesville Office (704) 878-5305 Mooresville Office (704) 660-3625 PERMIT # 176808

IMPROVEMENT PERMIT / AUTHORIZATION TO CONSTRUCT / OPERATION PERMIT / EXISTING SYSTEM

PIN # 4722381801

APPLICANT: Dana Blalock APPLICANT ADDRESS: 126 Golden Oak Dr.

SITE ADDRESS: 130 Pinkney Ln. PHONE: 704-775-3508 ALT. PHONE: N/A

SITE DIRECTIONS: Buffalo Shoals Rd TR old Mtn. Rd. TR Pinkney Ln.

SUBDIVISION: Kyles Wood SECTION: N/A LOT # 10 LOT AREA: 0.74 acres DESIGN FLOW: 360 gpd L.T.A.R.: 0.25

Septic Tank	Existing	(gal)	STB		Date						
Pump Tank		(gal)	PT		Date						
Pump Make			Model		Serial #						
# Nitrification Fields	1		# Lines	2	Linear Ft:	132					
Trench Width	36"		Max. Trench Bottom Depth	36"	Gravel Depth	N/A					

☐ New System ☑ Repair ☐ Expansion System Type: I II III IV V VI

System Description:

Repair System Description: 25% Reduction + Existing

Maintenance Agreement Required: ☐ YES ☑ NO

☑ GRAVITY ☐ PRESSURE

☑ Residence No. Bedrooms 3

☐ Business No. Persons

☐ Other No. Employees

☐ Slab ☑ Crawl Space

☐ Basement w/plumbing ☐ Basement w/o plumbing

Water Supply


☐ Private

☐ Public


☑ Community

Comments / Conditions: Install 132' of 25% Reduction System on contour with serial distribution. Connect to existing drainfield as shown below.

INITIAL SITE SKETCH

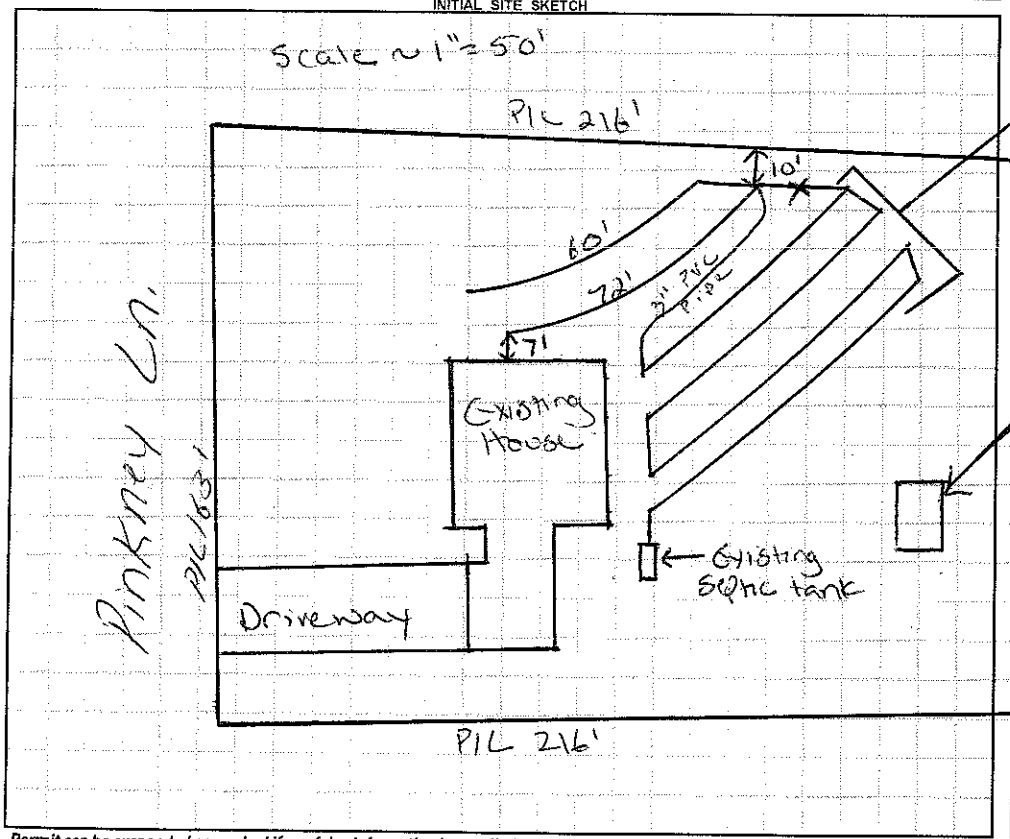

AS BUILT SKETCH

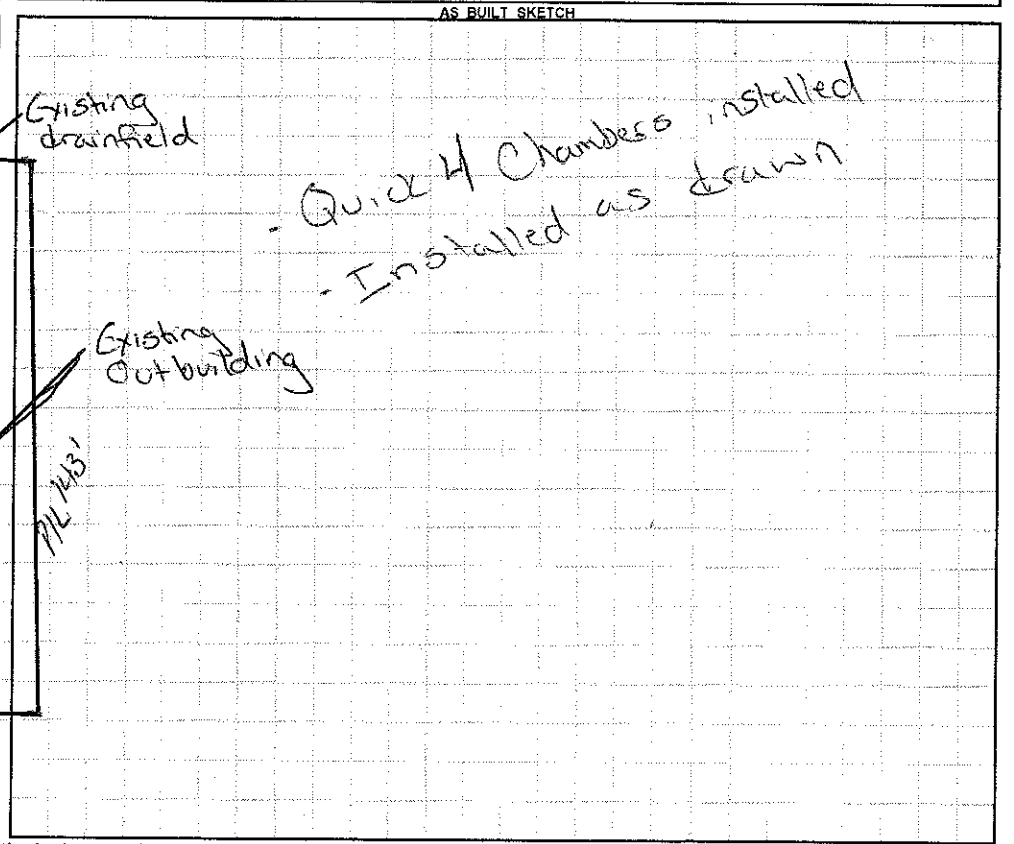

Permit can be suspended or revoked if any false information is supplied toward securing the permit / any unauthorized changes are made to the site / any unauthorized changes are made in the installation of the system. **CONTACT A LOCATOR SERVICE PRIOR TO ANY EXCAVATION**

☐ **IMPROVEMENT PERMIT** *with plat valid without expiration.* ☑ **IMPROVEMENT PERMIT** *with site plan valid for 60 mos.* ☑ **AUTHORIZATION TO CONSTRUCT** *valid for period equal to IMPROVEMENT PERMIT--not to exceed 60 mo.*

Owner / Applicant Signature: D.K. Blalock Date: 2-8-13 Installed by: Steve Jordan

IMPROVEMENT PERMIT by: Justin D Henderson Date: 2-5-13 OPERATION PERMIT by: Justin D Henderson Date: 3-14-13

AUTHORIZATION TO CONSTRUCT by: Justin D Henderson Date: 2-5-13 Existing System Inspected by: Date:

Health Dept. Copy - WHITE Applicant (Final Approval) - YELLOW Applicant (Conditional Approval) - PINK