IREDELL COUNTY HEALTH DEPARTMENT

STATESVILLE 704-878-5305 MOORESVILLE 704-664-5281

IMPROVEMENT PERMIT / AUTHORIZATION TO CONSTRUCT / OPERATION PERMIT / EXISTING SYSTEM INSPECTION

PERMIT# 79533 PIN# 4722381944 DATE 3-10-99

OWNER OR CONTRACTOR Chris Davidson PHONE: Business 528 6192 Home

ADDRESS PO Box 257 Troutman N.C.

LOCATION Old mtn Rd TR Pinkney on rt near End

SUBDIVISION Kylewood BLOCK / SECTION 1 LOT 10 LOT AREA .172 acres SITE CLASS PS DESIGN FLOW 360 L.T.A.R. .3

Septic Tank: 1000 Gallons; STB 10/2 Date 4-12-99
Pump Tank: 1000 Gallons; PT 17 Date 4-22-99
Pump Make: Gould Model WE05H Serial No. C995677
Nitrification Field: No Fields 1 Square Feet 900 Linear Feet 300
No Lines 6 Trench Width 36" Max Trench Bottom Depth 36 Gravel Depth 12"

☑ New System ☐ Repair System Type: I. II ☐ IV. V. VI
System Description: Pump To 25% Ret
Repair System Description: Pump To LPP Panels
Maintenance Agreement Required: ☐ Yes ☑ No

☑ House/Mod. Home ☐ Mobile Home ☐ Business ☐ Other
No. Bedrooms 3 No. Bathrooms 2 No. Employees


☐ Slab ☑ Crawl Space ☐ Basement w/plumbing ☐ Basement wo/plumbing

Water Supply: ☐ Individual ☑ Public ☐ Community


Comments/Conditions:

Comments/Conditions
5-28 Checked Lines, Tank
Pressure check 8-11-99 JCM
Wiring + Alarm 8-11-99 JCM

INITIAL SITE SKETCH 206'

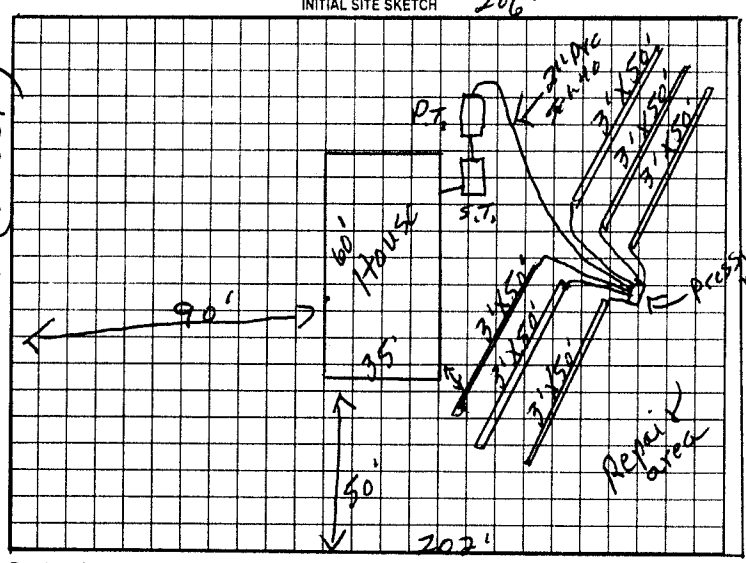

AS BUILT SKETCH

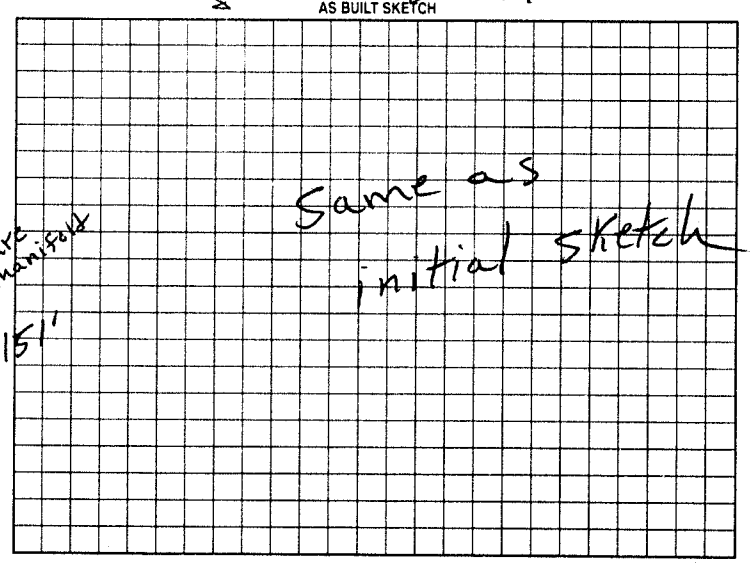

Permit can be suspended or revoked if any false information is supplied toward securing the permit/any unauthorized changes are made to the site/any unauthorized changes are made in the installation of the system. Improvement Permit with plat valid without expiration. Improvement Permit with site plan valid for sixty months. Authorization to Construct is valid for a period equal to that of Improvement Permit – not to exceed sixty months.

Signed: [signature] date 3-22-99 Installed by: David Yountz

Improvement Permit by: R. C. Moore date 3-10-99 Operation Permit by: R. C. Moore date 8-11-99

Authorization to Construct by: R. C. Moore date 3-10-99 Existing System Inspection by: date

HEALTH DEPT COPY: WHITE OWNER COPY (FINAL): YELLOW OWNER COPY (INITIAL): PINK