John Troutman

IREDELL COUNTY HEALTH DEPARTMENT

STATESVILLE 704-878-5305 MOORESVILLE 704-664-5281

IMPROVEMENT PERMIT / AUTHORIZATION TO CONSTRUCT / OPERATION PERMIT / EXISTING SYSTEM INSPECTION

PERMIT# 82089 PIN# 4722398053 DATE 7-1-99

OWNER OR CONTRACTOR D+D Enterprizes PHONE: Business 528 6192 Home

ADDRESS PO Box 252 Troutman N.C.

LOCATION Buffalo Shoals Rd on Rt before old mtn Rd

SUBDIVISION Kylewood BLOCK / SECTION 3 LOT 23 LOT AREA 1.12 acres SITE CLASS PS DESIGN FLOW 150 L.T.A.R. .25

Septic Tank: 1000 Gallons; STB 160 Date 11-8-99

Pump Tank: Gallons; PT Date

Pump Make: Model Serial No.

Nitrification Field: No Fields 1 Square Feet 600 Linear Feet 200

No Lines 3 Trench Width 36" Max Trench Bottom Depth 36" Gravel Depth 12"

☑ New System ☐ Repair System Type: I, II, III, IV, V, VI

System Description: Conv. Gravity

Repair System Description:

Maintenance Agreement Required: ☐ Yes ☑ No

☐ House/Mod. Home No. Bedrooms 2

☐ Mobile Home No. Bathrooms

☐ Business No. Employees 6

☐ Other warehouse + wholesale + manufacturing

☑ Slab ☐ Crawl Space ☐ Basement w/plumbing ☐ Basement w/o plumbing


Water Supply: ☐ Individual ☐ Public ☑ Community

Comments/Conditions:


Comments/Conditions: System for Domestic Sewage Flow only No industrial waste water

1311 (Sheet)

INITIAL SITE SKETCH

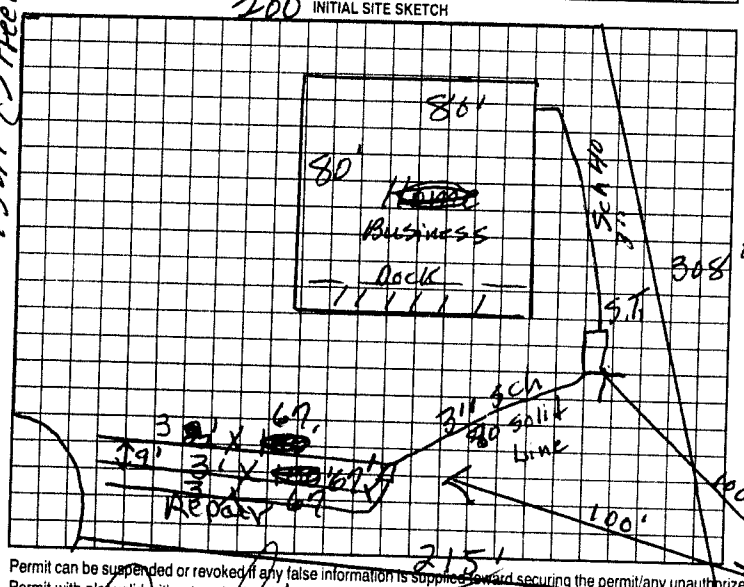

AS BUILT SKETCH

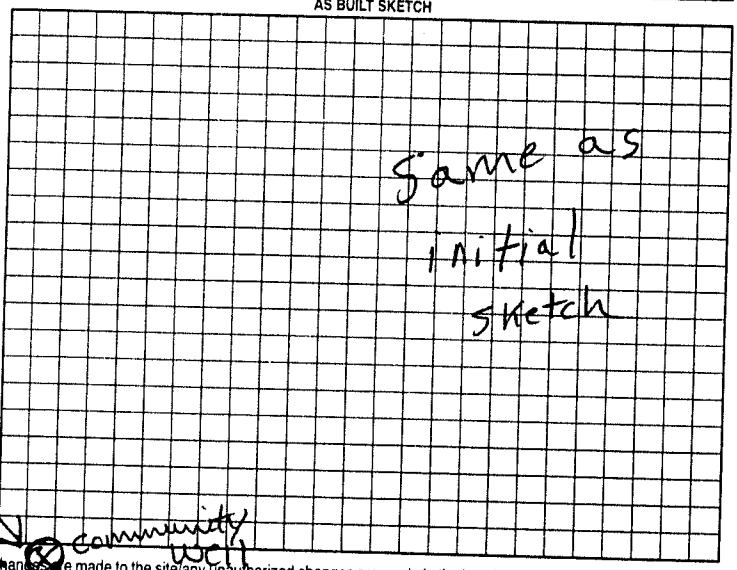

Permit can be suspended or revoked if any false information is supplied toward securing the permit/any unauthorized changes are made to the site/any unauthorized changes are made in the installation of the system. Improvement Permit with plat valid without expiration. Improvement Permit with site plan valid for sixty months. Authorization to Construct is valid for a period equal to that of Improvement Permit – not to exceed sixty months.

Signed: [signature] date 7/8/99 Installed by: Barry Sigmon

Improvement Permit by: R.C. Moore date 7-1-99 Operation Permit by: R.C. Moore date 3-7-00

Authorization to Construct by: R.C. Moore date 7-1-99 Existing System Inspection by: date

HEALTH DEPT. COPY: WHITE OWNER COPY (FINAL): YELLOW OWNER COPY (INITIAL): PINK