IREDELL COUNTY HEALTH DEPARTMENT

STATESVILLE 704-878-5305 MOORESVILLE 704-664-5281

IMPROVEMENT PERMIT / AUTHORIZATION TO CONSTRUCT / OPERATION PERMIT / EXISTING SYSTEM INSPECTION

PERMIT# 73634 PIN# 4722398053 DATE 6-8-98

OWNER OR CONTRACTOR Chris Davidson PHONE: Business 528 6192 Home

ADDRESS 212 Buffalo Shoals Rd LOCATION Statesville N.C. SUBDIVISION Loblolly Ln West on Left Right before Kyles X Roads

BLOCK / SECTION LOT LOT AREA 1 acre SITE CLASS. PS DESIGN FLOW 250 L.T.A.R. .3

Septic Tank: 1000 Gallons; STB 1007 Date 3-16-98
Pump Tank: Gallons; PT Date
Pump Make: Model Serial No. 370
Nitrification Field: No Fields 1 Square Feet 840 Linear Feet ~~350~~
No Lines 3 Trench Width 36 Max Trench Bottom Depth 36 Gravel Depth 12"

☑ New System ☐ Repair System Type: I, II, III, IV, V, VI
System Description: Conv. Gravity
Repair System Description: " "
Maintenance Agreement Required: ☐ Yes ☑ No

☐ House/Mod. Home ☐ Mobile Home ☑ Business ☐ Other Warehouse + Office
No. Bedrooms No. Bathrooms 2 No. Employees 10


☐ Slab ☐ Crawl Space ☐ Basement w/plumbing ☐ Basement wo/plumbing

Water Supply: ☐ Individual ☐ Public ☑ Community


Comments:/Conditions:

Comments:/Conditions:

INITIAL SITE SKETCH

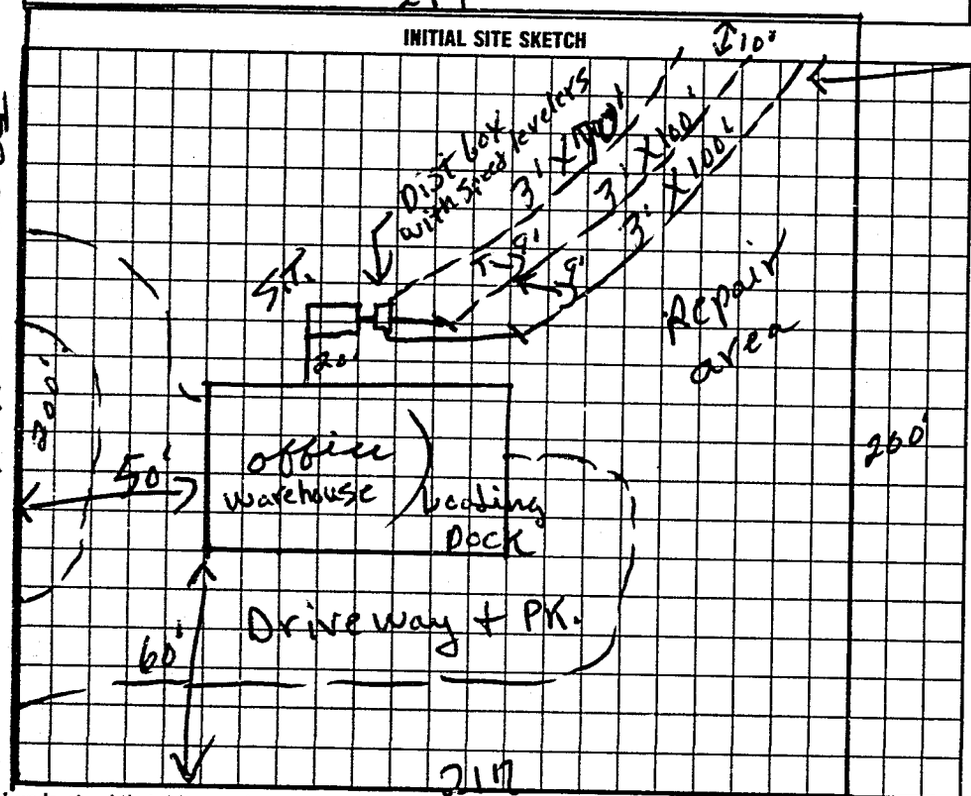

AS BUILT SKETCH

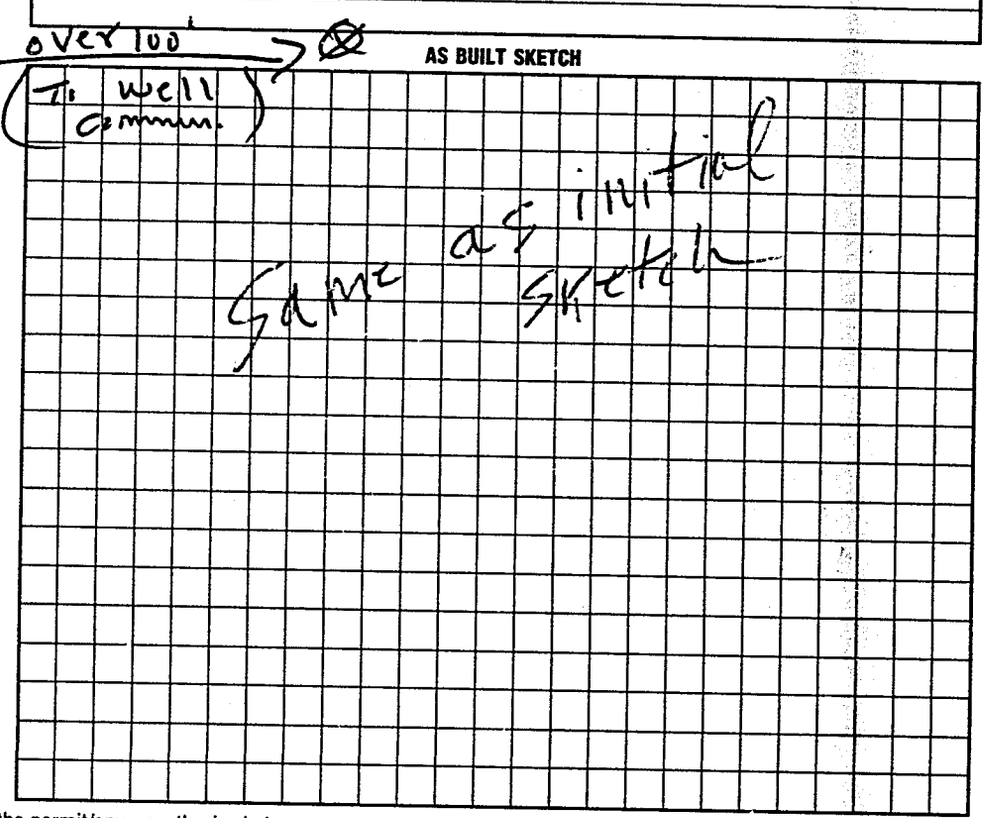

I understand that this permit can be suspended or revoked if any false information is supplied toward securing the permit/any unauthorized changes are made to the site/any unauthorized changes are made in the installation of the system. Improvement Permit with plat valid without expiration. Improvement Permit with site plan valid for sixty months. Authorization to Construct is valid for a period equal to that of Improvement Permit – not to exceed sixty months.

Signed: Neil Hyle date 6-14-98

Improvement Permit by: P. C. Moore date 6-8-98

Authorization to Construct by: P. C. Moore date 6-8-98

Installed by: Chris Davidson

Operation Permit by: P. C. Moore date 10-22-98

Existing System Inspection by: date

HEALTH DEPT COPY WHITE INSPECTION COPY (FINAL) GREEN OWNER COPY (FINAL): YELLOW INSPECTION COPY (INITIAL): PINK OWNER COPY (INITIAL): GOLD

S26000