IREDELL COUNTY HEALTH DEPARTMENT

STATESVILLE 704-878-5305 MOORESVILLE 704-664-5281

IMPROVEMENT PERMIT / AUTHORIZATION TO CONSTRUCT / OPERATION PERMIT / EXISTING SYSTEM INSPECTION

PERMIT# 90511 PIN# 4722 38 7679 DATE 7-20-00

OWNER OR CONTRACTOR Kyles Development Corp. PHONE: Business 528 6192 Home

ADDRESS PO Box 5602 Statesville, N.C.

LOCATION Buffalo Shoales TR Braeburn on pt at cornor

SUBDIVISION Kyles Woods BLOCK / SECTION III LOT 26 LOT AREA 1 ac SITE CLASS. PS DESIGN FLOW 300 L.T.A.R. .33

Septic Tank: 1000 Gallons; STB 1007 Date 4-4-05
Pump Tank: Gallons; PT Date
Pump Make: Model Serial No.
Nitrification Field: No Fields 1 Square Feet 900 Linear Feet 300
No Lines 2 Trench Width 36" Max Trench Bottom Depth 36" Gravel Depth 12"

☑ New System ☐ Repair System Type: I, II, III, IV, V, VI
System Description: Conv. Gravity
Repair System Description: Pump to conv.
Maintenance Agreement Required: ☐ Yes ☑ No

☐ House/Mod. Home No. Bedrooms
☐ Mobile Home No. Bathrooms
☑ Business No. Employees 12
☐ Other Office Detail


☑ Slab ☐ Crawl Space ☐ Basement w/plumbing ☐ Basement wo/plumbing

Water Supply: ☐ Individual ☐ Public ☑ Community


Comments:/Conditions:

Comments:/Conditions: SEPTIC TANK WITH MARKER INSTALLED USING "ZABEL" FILTER

INITIAL SITE SKETCH

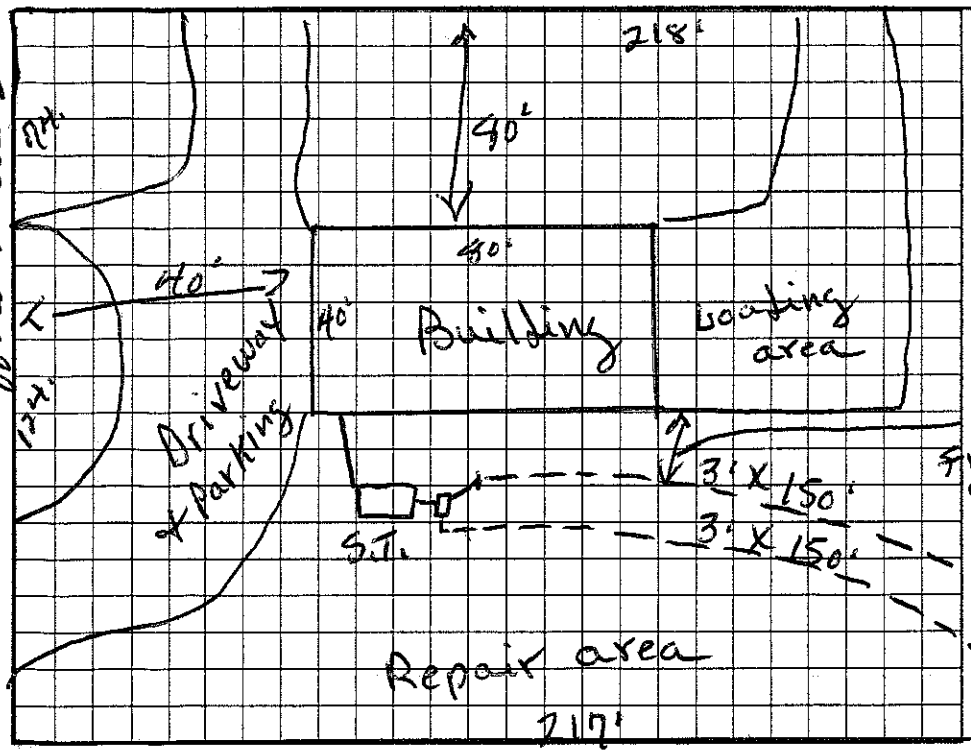

AS BUILT SKETCH

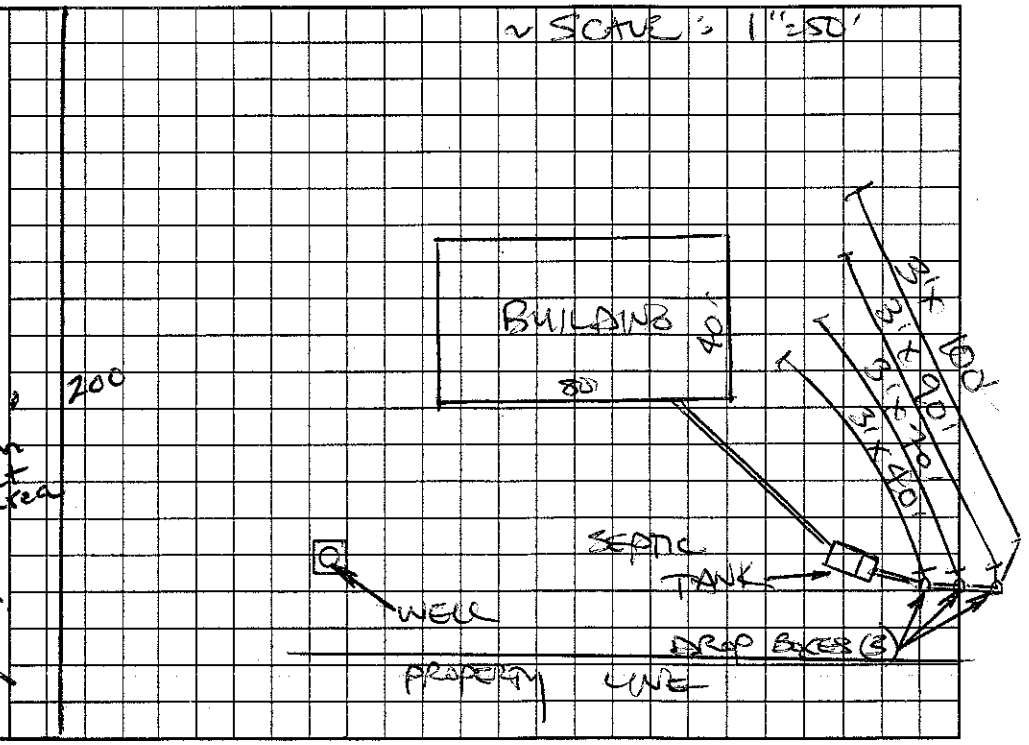

Permit can be suspended or revoked if any false information is supplied toward securing the permit/any unauthorized changes are made to the site/any unauthorized changes are made in the installation of the system. Improvement Permit with plat valid without expiration. Improvement Permit with site plan valid for sixty months. Authorization to Construct is valid for a period equal to that of Improvement Permit – not to exceed sixty months.

Signed: X date Installed by: L & L CONSTRUCTION of STVL

Improvement Permit by: P. C. Moore date 7-20-00 Operation Permit by: STEVE HENDRICK date 5-4-05

Authorization to Construct by: P. C. Moore date 7-20-00 Existing System Inspection by: date

HEALTH DEPT. COPY: WHITE OWNER COPY (FINAL): YELLOW OWNER COPY (INITIAL): PINK