IREDELL COUNTY HEALTH DEPARTMENT

STATESVILLE 704-878-5305 MOORESVILLE 704-664-5281

IMPROVEMENT PERMIT / AUTHORIZATION TO CONSTRUCT / OPERATION PERMIT / EXISTING SYSTEM INSPECTION

PERMIT# 72421 PIN# 4722 39 0241 DATE 3-23-98

OWNER OR CONTRACTOR Chris Davidson PHONE: Business 528 6192 Home

ADDRESS 212 Lobelly Ln

LOCATION Buffalo Shoals TR 015 mtn. TR Pickney on left end

SUBDIVISION Kyle Wood BLOCK / SECTION LOT 6 LOT AREA 1.02 acres SITE CLASS PS DESIGN FLOW 360 L.T.A. 1.3

Septic Tank: 1000 Gallons; STB 1012 Date 5-29-00

Pump Tank: Gallons; PT Date

Pump Make: Model Serial No.

Nitrification Field: No Fields 1 Square Feet 900 Linear Feet 300

No Lines 3 Trench Width 36" Max Trench Bottom Depth 36" Gravel Depth N/A

[ ] New System [ ] Repair System Type: I, II, (III) IV, V, VI

System Description: Gravity/Chamber

Repair System Description: Pump to Chambers

Maintenance Agreement Required: [ ] Yes [ ] No

[ ] House/Mod. Home No. Bedrooms 3

[ ] Mobile Home No. Bathrooms 2

[ ] Business No. Employees

[ ] Other


[ ] Slab [ ] Crawl Space [ ] Basement w/plumbing [ ] Basement wo/plumbing

Water Supply: [ ] Individual [ ] Public [ ] Community

Comments:/Conditions:

Comments:/Conditions:

INITIAL SITE SKETCH

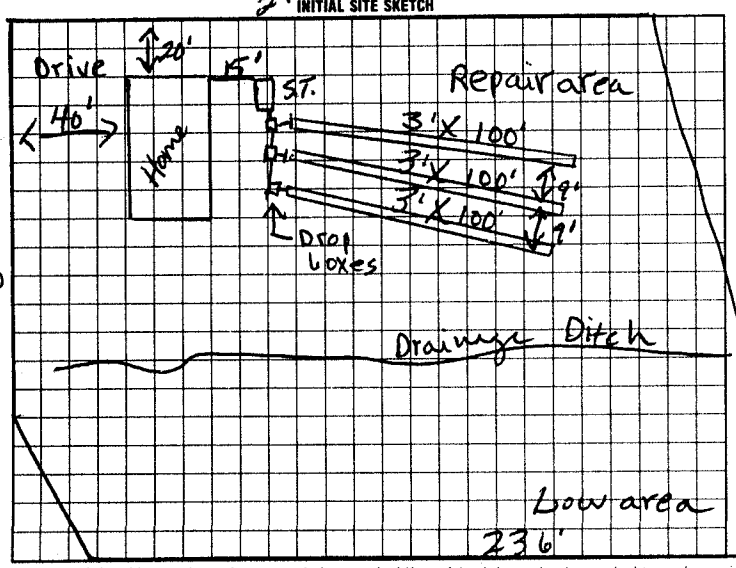

AS BUILT SKETCH

I understand that this permit can be suspended or revoked if any false information is supplied toward securing the permit/any unauthorized changes are made to the site/any unauthorized changes are made in the installation of the system. Improvement Permit with plat valid without expiration. Improvement Permit with site plan valid for sixty months. Authorization to Construct is valid for a period equal to that of Improvement Permit – not to exceed sixty months.

Signed: Neil Kale date

Improvement Permit by: P.C. Moore date 3-27-98

Authorization to Construct by: P.C. Moore date 3-23-98

Installed by: David Yountz

Operation Permit by: date 8-15-00

Existing System Inspection by: date

HEALTH DEPT. COPY WHITE INSPECTION COPY (FINAL) GREEN OWNER COPY (FINAL) YELLOW INSPECTION COPY (INITIAL) PINK OWNER COPY (INITIAL) GOLD