pd 725 2-16-98

IREDELL COUNTY HEALTH DEPARTMENT

STATESVILLE 704-878-5305 MOORESVILLE 704-664-5281

IMPROVEMENT PERMIT / AUTHORIZATION TO CONSTRUCT / OPERATION PERMIT / EXISTING SYSTEM INSPECTION

PERMIT# 71800 PIN# 4722 39 3272 DATE 2-10-98

OWNER OR CONTRACTOR Chris Dawson PHONE: Business 704 528 6192 Home

ADDRESS 212 Loblolly Ln Statesville

LOCATION Old mtn Rd Turn at Kyles-x-Rds on Pinkney ln on Rt before end

SUBDIVISION Kylewood BLOCK / SECTION LOT 9 LOT AREA 1.79 acres SITE CLASS PS DESIGN FLOW 360 L.T.A.R. .3

Septic Tank: 1000 Gallons; STB 1012 Date 7/3 99
Pump Tank: 1000 Gallons; PT 17 TP Date 5 9 99
Pump Make: Goleas Model WE0511HH Serial No. AM 1834862
Nitrification Field: No Fields 1 Square Feet 900 Linear Feet 300
No Lines 3 Trench Width 36" Max Trench Bottom Depth 36" Gravel Depth N/A

☑ New System ☐ Repair System Type: I, II, ☑ III, IV, V, VI
System Description: Pump To Chambers
Repair System Description: " " " " or HP
Maintenance Agreement Required: ☐ Yes ☐ No
☐ Slab ☐ Crawl Space ☐ Basement w/plumbing ☐ Basement wo/plumbing


☑ House/Mod. Home No. Bedrooms 3
☐ Mobile Home No. Bathrooms 2
☐ Business No. Employees
☐ Other

Water Supply: ☐ Individual ☐ Public ☑ Community


Comments/Conditions: See Attached Sheets for P.T. Setup pressure manifold + Cleanout 177' which are part of This Permit.

Comments/Conditions: 9-20 Line Inspected OK 9 22

INITIAL SITE SKETCH

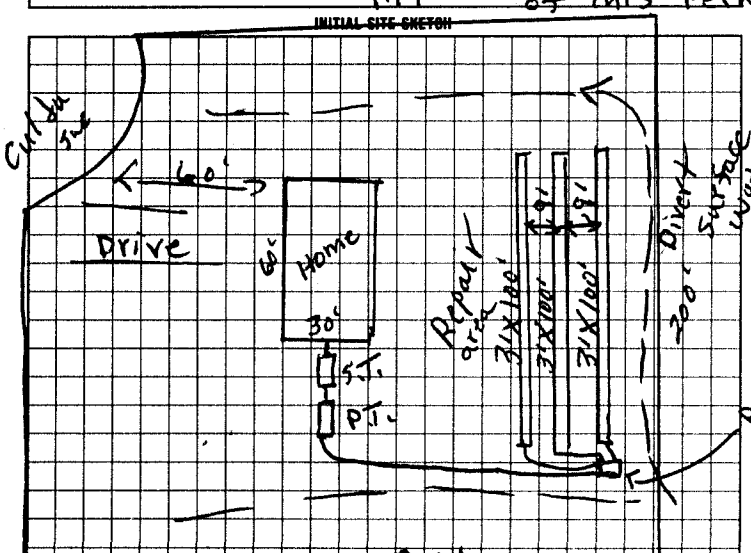

AS BUILT SKETCH

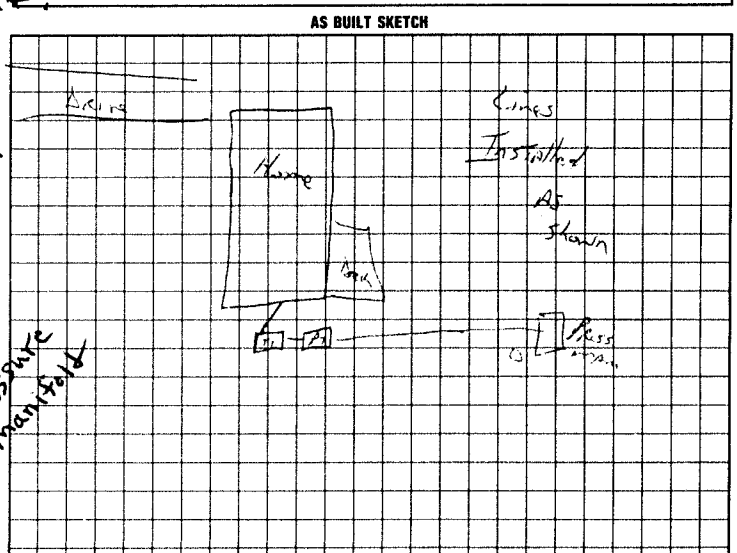

I understand that this permit can be suspended or revoked if any false information is supplied toward securing the permit/any unauthorized changes are made to the site/any unauthorized changes are made in the installation of the system. Improvement Permit with plat valid without expiration. Improvement Permit with site plan valid for sixty months. Authorization to Construct is valid for a period equal to that of Improvement Permit – not to exceed sixty months.

Signed: Kent W Shi date

Installed by: Eddie Younts & Son

Improvement Permit by: P.C. Moore date 2-10-98

Operation Permit by: [illegible] date Sept 22, 99

Authorization to Construct by: P.C. Moore date 2-10-98

Existing System Inspection by: date

HEALTH DEPT. COPY: WHITE INSPECTION COPY (FINAL): GREEN OWNER COPY (FINAL) YELLOW INSPECTION COPY (INITIAL) PINK OWNER COPY (INITIAL): GOLD