IREDELL COUNTY HEALTH DEPARTMENT

STATESVILLE 704-878-5305 MOORESVILLE 704-664-5281

IMPROVEMENT PERMIT / AUTHORIZATION TO CONSTRUCT / OPERATION PERMIT / EXISTING SYSTEM INSPECTION

PERMIT# 40911 PIN# 4723172097 DATE 5-5-99

OWNER OR CONTRACTOR Chris Davidson (Kyles Development) PHONE: Business 528 6192 Home

ADDRESS PO Box 252 Trautman

LOCATION Buffalo Shoals TR Bobtail Ln 4th lot left

SUBDIVISION Kylewood BLOCK / SECTION 1 LOT 18 LOT AREA .73 ACRES SITE CLASS PS DESIGN FLOW 360 L.T.A.R. 3

Septic Tank: 1000 Gallons; STB 1012 Date 9-5-00

Pump Tank: Gallons; PT Date

Pump Make: Model Serial No

Nitrification Field: No Fields 1 Square Feet 900 Linear Feet 300

No Lines 3 Trench Width 36" Max Trench Bottom Depth 36" Gravel Depth N/A

☐ New System ☐ Repair System Type: I II III IV V VI

System Description: Gravity 25% Reduction

Repair System Description:

Maintenance Agreement Required: ☐ Yes ☑ No

☑ House/Mod. Home No. Bedrooms 3

☐ Mobile Home No. Bathrooms 2

☐ Business No. Employees

☐ Other


☐ Slab ☑ Crawl Space ☐ Basement w/plumbing ☐ Basement wo/plumbing

Water Supply: ☑ Individual ☐ Public ☐ Community

Comments/Conditions:


200'

INITIAL SITE SKETCH

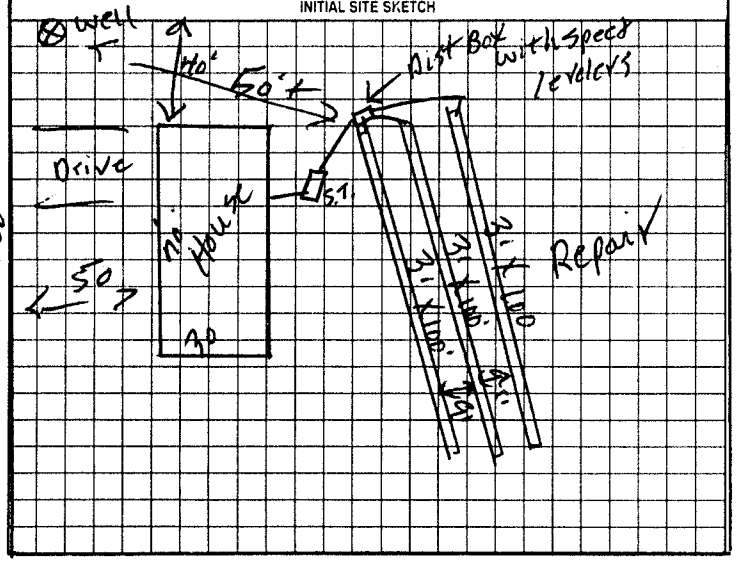

Comments/Conditions: ① SEPTIC TANK WITH RISERS INSTALLED USING "POLYLOK" FILTER ② 50 "INFILTRATOR" CHAMBERS ACCORDING TO INITIAL SITE SKETCH

AS BUILT SKETCH

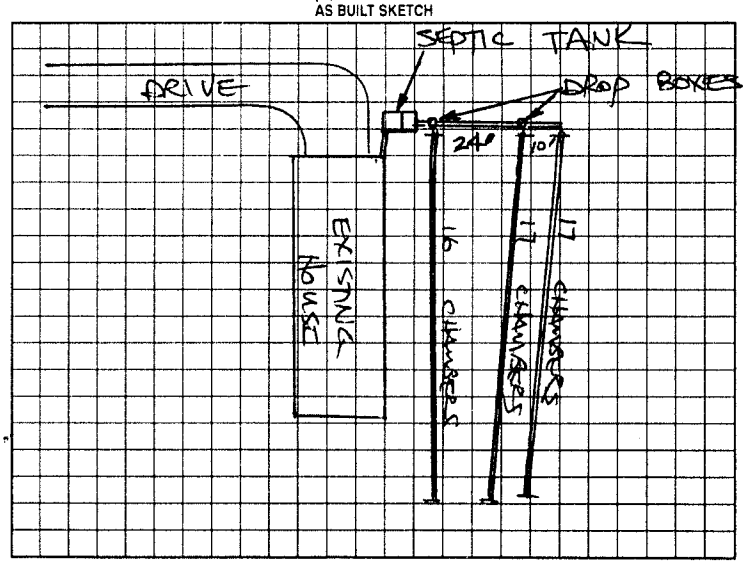

Permit can be suspended or revoked if any false information is supplied toward securing the permit/any unauthorized changes are made to the site/any unauthorized changes are made in the installation of the system. Improvement Permit with plat valid without expiration. Improvement Permit with site plan valid for sixty months. Authorization to Construct is valid for a period equal to that of Improvement Permit – not to exceed sixty months.

Signed: Neil Kale date 5-14-99 Installed by: DAVID YOUNTZ

Improvement Permit by: R. C. Moore date 5-5-99 Operation Permit by: STEVE HERRICK date 12-28-00

Authorization to Construct by: R. C. Moore date 5-5-99 Existing System Inspection by: date

HEALTH DEPT COPY WHITE OWNER COPY (FINAL) YELLOW OWNER COPY (INITIAL) PINK