177247

# IREDELL COUNTY HEALTH DEPARTMENT

STATESVILLE 704-878-5305 MOORESVILLE 704-664-5281

## IMPROVEMENT PERMIT / AUTHORIZATION TO CONSTRUCT / OPERATION PERMIT / EXISTING SYSTEM INSPECTION

PERMIT# 80912 PIN# 4723-72-0494 4722-39-7053 DATE 5-4-99

OWNER OR CONTRACTOR Chris Davidson Kyles Developmnt PHONE: Business 528-6192 Home

ADDRESS P O Box 257 Troutman N.C.

LOCATION Buffalo shoals TR 3rd lot left OFF OLAND LN.

SUBDIVISION Kyle Woods BLOCK / SECTION 2 LOT 17 LOT AREA 1.73acres SITE CLASS. A5 DESIGN FLOW 360 L.T.A.R. 1.3

Septic Tank: 1000 Gallons; STB 1012 Date 09/11/02
Pump Tank: Gallons; PT Date
Pump Make: Model Serial No.
Nitrification Field: No Fields 1 Square Feet 900 Linear Feet 300
No Lines 4 Trench Width 36" Max Trench Bottom Depth 36" Gravel Depth N/A

☐ New System ☐ Repair System Type: I, II, III, IV, V, VI
System Description: Gravity/ 25% Reduction
Repair System Description:
Maintenance Agreement Required: ☐ Yes ☑ No


☑ House/Mod. Home No. Bedrooms 3
☐ Mobile Home No. Bathrooms 2
☐ Business No. Employees
☐ Other
☐ Slab ☑ Crawl Space ☐ Basement w/plumbing ☐ Basement w/o plumbing

Water Supply: ☑ Individual ☐ Public ☐ Community

Comments:/Conditions:

200'


INITIAL SITE SKETCH

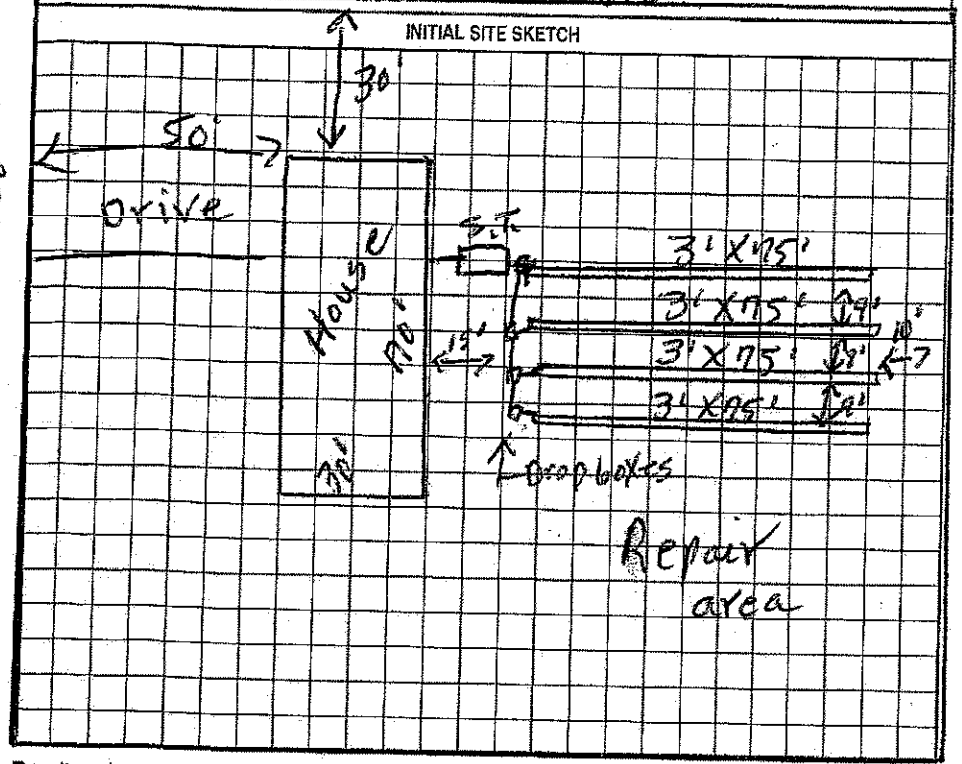


Comments:/Conditions:

* SEPTIC TANK INSTALLED USING [redacted] TUFF-TITE FILTER.

AS BUILT SKETCH

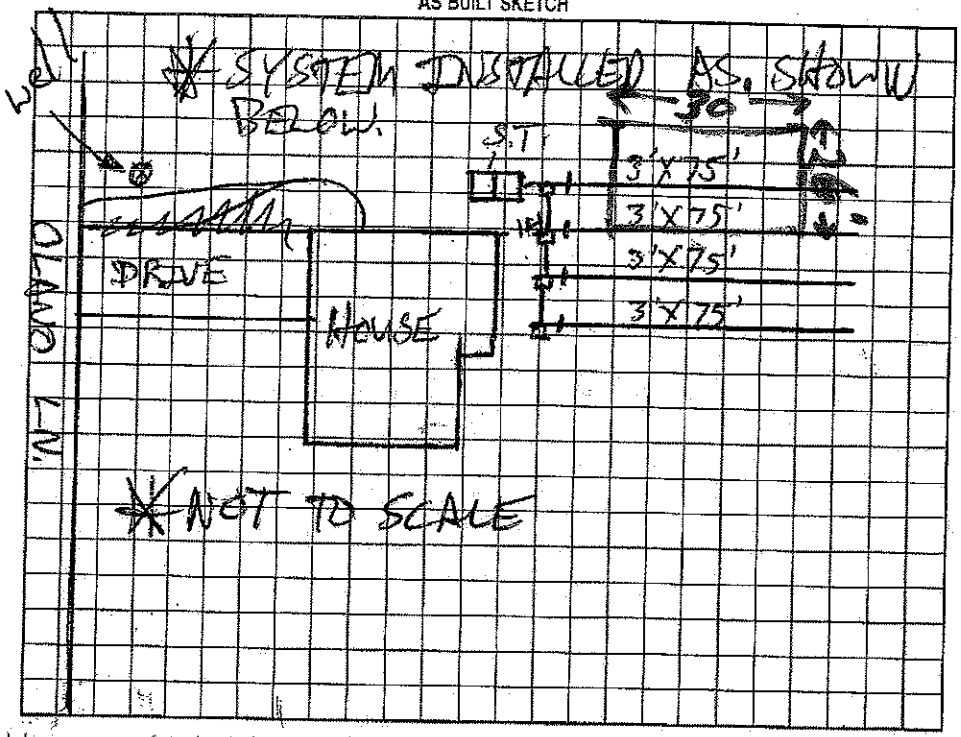


Permit can be suspended or revoked if any false information is supplied toward securing the permit/any unauthorized changes are made to the site/any unauthorized changes are made in the installation of the system. Improvement Permit with plat valid without expiration. Improvement Permit with site plan valid for sixty months. Authorization to Construct is valid for a period equal to that of Improvement Permit – not to exceed sixty months.

Signed: Neil Kale date 5-14-99

Improvement Permit by: R. C. Moore date 5-4-99

Authorization to Construct by: R. C. Moore date 5-4-99

Installed by: PAVED YOUNTZ 04/28/03

Operation Permit by: [signature] date 04/28/03

Existing System Inspection by: date

HEALTH DEPT. COPY: WHITE OWNER COPY (FINAL): YELLOW OWNER COPY (INITIAL): PINK