IREDELL COUNTY HEALTH DEPARTMENT

STATESVILLE 704-878-5305 (C1) MOORESVILLE 704-664-5281

IMPROVEMENT PERMIT / AUTHORIZATION TO CONSTRUCT / OPERATION PERMIT / EXISTING SYSTEM INSPECTION

PERMIT# 115021 PIN# 4722-44-~~1243~~1264 DATE 8-27-03

OWNER OR CONTRACTOR T.J. & CHRISSY DILLARD PHONE: Business 704-924-2112 Home 704-873-1021

ADDRESS 119 OLD CHRISTY LANE, CLEVELAND NC 27013

LOCATION US 21 S, TR OLD MOUNTAIN ROAD, TL COMPTON PARK ROAD, 1ST LOT ON RIGHT PAST FRED LEE DR.

SUBDIVISION _____ BLOCK / SECTION _____ LOT _____ LOT AREA ~ 1 ACRE SITE CLASS. PS1 DESIGN FLOW 360 L.T.A.R. 0.30 GAD/FT²

Septic Tank: 1000 Gallons; STB 620 Date 8-8-03
Pump Tank: _____ Gallons; PT _____ Date _____
Pump Make: _____ Model _____ Serial No. _____
Nitrification Field: No Fields 1 Square Feet 1200 Linear Feet 400
No Lines SIX Trench Width 36" Max Trench Bottom Depth 30" Gravel Depth 12"

☑ New System ☐ Repair System Type: I, II, III, IV, V, VI
System Description: CONVENTIONAL GRAVITY
Repair System Description: PUMP TO SEPTIC REPAIR
Maintenance Agreement Required: ☐ Yes ☑ No


☑ House/Mod. Home No. Bedrooms 3
☐ Mobile Home No. Bathrooms 3
☐ Business No. Employees ____
☐ Other _____
☐ Slab ☑ Crawl Space ☐ Basement w/plumbing ☐ Basement wo/plumbing

Water Supply: ☑ Individual ☐ Public ☐ Community WELL

Comments:/Conditions: KEEP SYSTEM MINIMUM 100 FEET FROM WELL, 10 FEET FROM PROPERTY LINE. INSTALL LINES NO DEEPER THAN 30"

Comments:/Conditions: SEPTIC TANK WITH MARKER & RISERS INSTALLED USING "ZABEL" FILTER

INITIAL SITE SKETCH

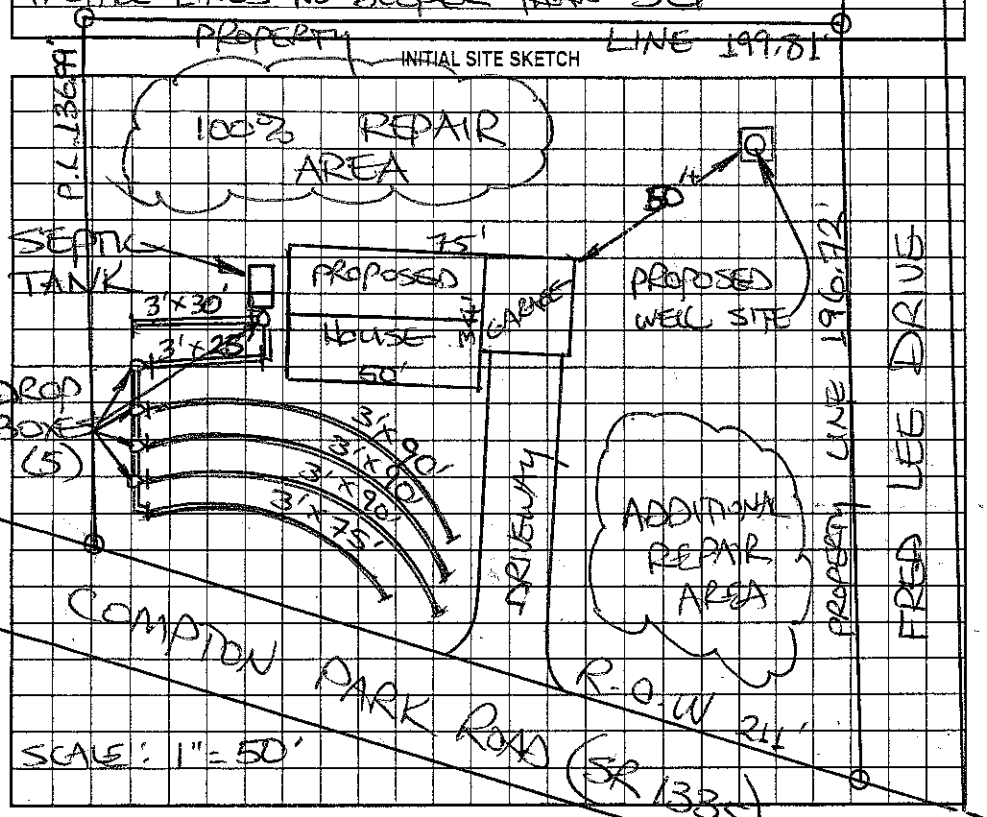

AS BUILT SKETCH

SYSTEM INSTALLED ACCORDING TO INITIAL SITE SKETCH

Permit can be suspended or revoked if any false information is supplied toward securing the permit/any unauthorized changes are made to the site/any unauthorized changes are made in the installation of the system. Improvement Permit with plat valid without expiration. Improvement Permit with site plan valid for sixty months. Authorization to Construct is valid for a period equal to that of Improvement Permit – not to exceed sixty months.

Signed: ✕ Chrissy Dillard date 8-27-03 Installed by: SAMMY REAVIS

Improvement Permit by: STEVE HEDRICK date 8-27-03 Operation Permit by: STEVE HEDRICK date 4-29-04

Authorization to Construct by: STEVE HEDRICK date 8-27-03 Existing System Inspection by: _____ date _____

HEALTH DEPT. COPY: WHITE OWNER COPY (FINAL): YELLOW OWNER COPY (INITIAL): PINK