IREDELL COUNTY HEALTH DEPARTMENT

STATESVILLE 704-878-5305 MOORESVILLE 704-664-5281

IMPROVEMENT PERMIT / AUTHORIZATION TO CONSTRUCT / OPERATION PERMIT / EXISTING SYSTEM INSPECTION

PERMIT# 090956 PIN# 4722450769 DATE 7/27/2000

OWNER OR CONTRACTOR Lisa Tomlin PHONE: Business 528-3068 Home John Clayton Homes 873-2547

ADDRESS 332 Ostwalt Amity Rd. Troutman, NC 28166

LOCATION Old Mountain Rd. TL Compton Pk TR Wright Rd. TL 1st Road (Dirt Road) on left

SUBDIVISION Compton Pk BLOCK / SECTION ____ LOT 8A LOT AREA 1.67 SITE CLASS. PS DESIGN FLOW 360 gpd L.T.A.R. ____

Septic Tank: 1000 Gallons; STB 1012 Date 5-12-00

Pump Tank: ____ Gallons; PT ____ Date ____

Pump Make: ____ Model ____ Serial No. ____

Nitrification Field: No Fields 1 Square Feet 1200'± Linear Feet 400'+

No Lines 5 at 80'+ Trench Width 36" Max Trench Bottom Depth 24"-36" Gravel Depth 12"

X New System ☐ Repair System Type: (I.) II. III. IV. V. VI

System Description: Gravity-Convention

Repair System Description Gravity-Innovative

Maintenance Agreement Required: ☐ Yes X No

☐ House/Mod. Home X Mobile Home ☐ Business ☐ Other

No. Bedrooms 3 No. Bathrooms 2 No. Employees ____


☐ Slab X Crawl Space ☐ Basement w/plumbing ☐ Basement wo/plumbing

Water Supply: X Individual ☐ Public ☐ Community

Comments/Conditions: Keep Septic System at least 10' from PL, From well 50-100' & 5' From house. Okay to use "Drop-Boxes" or Distribution box (Driveway CAN not Cross Septic System).

Comments/Conditions: SEPTIC TANK W/ RISERS INSTALLED USING "POLYLOK" FILTER

INITIAL SITE SKETCH Scale ~1:100

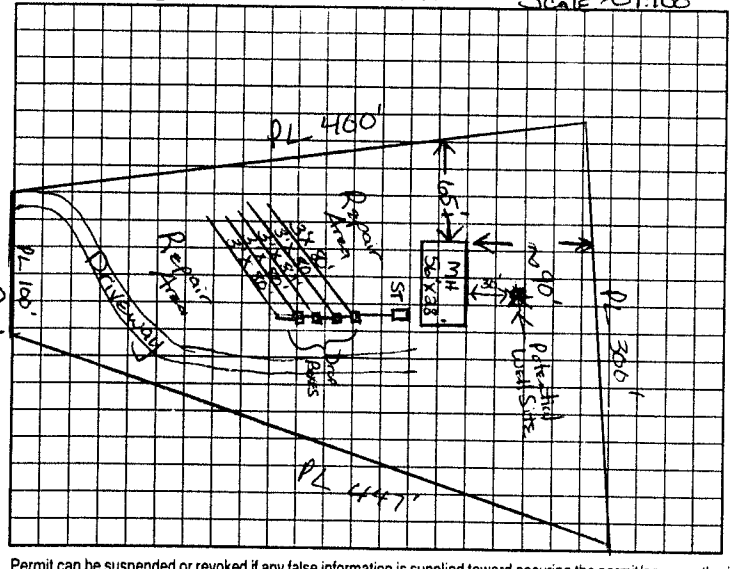

AS BUILT SKETCH

SYSTEM INSTALLED ACCORDING TO INITIAL SITE SKETCH

Permit can be suspended or revoked if any false information is supplied toward securing the permit/any unauthorized changes are made to the site/any unauthorized changes are made in the installation of the system. Improvement Permit with plat valid without expiration. Improvement Permit with site plan valid for sixty months. Authorization to Construct is valid for a period equal to that of Improvement Permit – not to exceed sixty months.

Signed: John Tomlin date 8-1-00

Improvement Permit by: Maria H. Dotson RS date 7/28/00

Authorization to Construct by: Maria H. Dotson RS date 7/28/00

Installed by: A-1 BACKHOE

Operation Permit by: STEVE HENDRICK date 8-7-00

Existing System Inspection by: ____ date ____

HEALTH DEPT. COPY: WHITE OWNER COPY (FINAL): YELLOW OWNER COPY (INITIAL): PINK