IREDELL COUNTY HEALTH DEPARTMENT

Statesville Office (704) 878-5305 Mooresville Office (704) 660-3625 PERMIT # 235957

SEPTIC IMPROVEMENT PERMIT / AUTHORIZATION TO CONSTRUCT / OPERATION PERMIT / EXISTING SYSTEM

PIN # 4712455205

APPLICANT/OWNER: Hyde Homes LLC/Walter+Christina Little APPLICANT ADDRESS: 129 Whispering Pine Rd

SITE ADDRESS: 172 Compton Park Rd, Statesville PHONE: 704-201-9935 ALT. PHONE —


SITE DIRECTIONS: Buffalo Shoals → L on Old Mountain Rd → R on Compton Park → on right SAP CONTROLLED: ☐ YES ☒ NO

SUBDIVISION: — SECTION: — LOT # — LOT AREA: .891 ac DESIGN FLOW: 300 L.T.A.R.: .25


Septic Tank 1000 (gal)	STB (existing) Date	☐ New System ☐ Repair ☐ Expansion System Type: I II III IV V VI	☒ Residence	No. Bedrooms 3	Water Supply
Pump Tank (gal)	PT Date	System Description: existing (2350)	☐ Business	No. Persons 10	☒ Private
Pump Make Model	Serial #	Repair System Description: 50% reduction	☐ Other	No. Employees	☐ Public
# Nitrification Fields 1	# Lines 10	Linear Ft 360	Maintenance Agreement Required: ☐ YES ☒ NO	☐ Slab	☒ Crawl Space	☐ Community
Trench Width 36"	Trench Bottom Depth(Low side) 36"	Gravel Depth N/A	☒ GRAVITY ☐ PRESSURE	☐ Basement w/plumbing	☐ Basement w/o plumbing

Comments / Conditions: Proposed pool / pool house will not impact repair area. Maintain 15ft+ from any pool cut

INITIAL SITE SKETCH

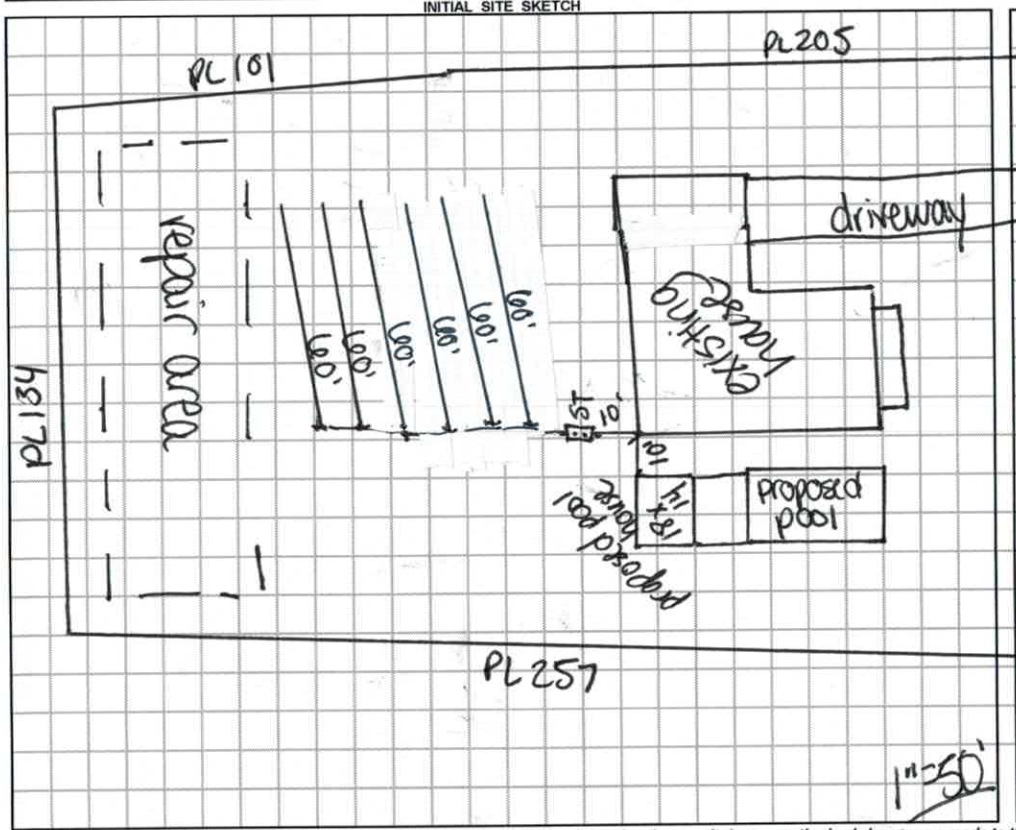

AS BUILT SKETCH

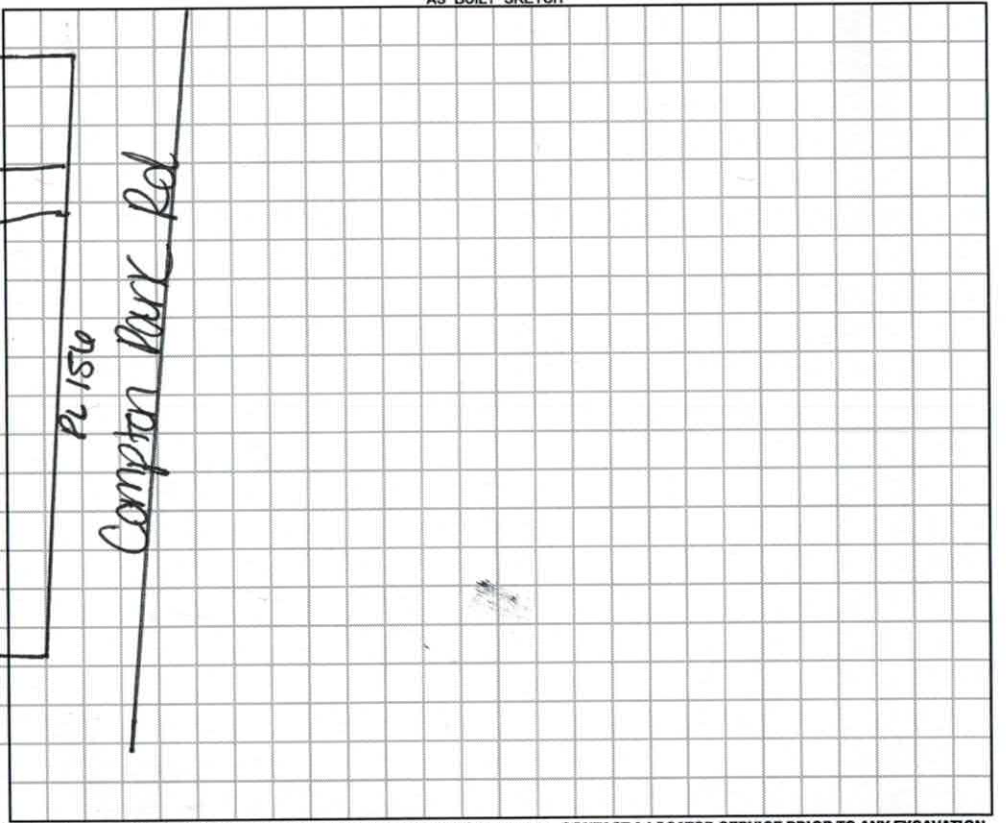

Permit can be suspended or revoked if any false information is supplied toward securing the permit / any unauthorized changes are made to the site / any unauthorized changes are made in the installation of the system. **CONTACT A LOCATOR SERVICE PRIOR TO ANY EXCAVATION**

☐ **IMPROVEMENT PERMIT** *with plat valid without expiration.* ☐ **IMPROVEMENT PERMIT** *with site plan valid for 60 mos.* ☐ **AUTHORIZATION TO CONSTRUCT** *valid for period equal to IMPROVEMENT PERMIT--not to exceed 60 mo.*

Owner / Applicant Signature: Joe Hyde Date: 6-1-18 Installed by:

IMPROVEMENT PERMIT by: Date: OPERATION PERMIT by: Date:

AUTHORIZATION TO CONSTRUCT by: Date: Existing System Inspected by: Carla C. Cave Date: 6/1/18

FOR SEPTIC FINAL INSPECTION: CALL 704-664-3703 between 8am-9am the day the inspection is needed. Be sure to speak with an inpsector to confirm your inspection time.

Need repair area

IREDELL COUNTY DEPARTMENT of ENVIRONMENTAL HEALTH

APPLICATION FORM

Application For: ( ) New Well Permit ( ) Well Repair Permit ( ) Well Abandonment
(✓) Septic Improvement Permit ( ) Authorization to Construct (✓) Existing System Inspection ( ) Septic System Repair

THE ABOVE PERMIT DOCUMENTS WILL BECOME INVALID IF INFORMATION PROVIDED ON THIS APPLICATION IS FALSIFIED OR CHANGED, OR IF THE SITE IS ALTERED. THE IMPROVEMENT PERMIT IS VALID FOR EITHER 60 MONTHS OR WITHOUT EXPIRATION DEPENDING UPON DOCUMENTATION SUBMITTED. APPLICATION WITH SITE PLAN 60 MONTHS, APPLICATION WITH COMPLETE, SCALED PLAT WITHOUT EXPIRATION. SEE 15A NCAC 18A .1937(f) FOR DETAILS.

23595

Page 2: *Site Plan Worksheet* form MUST accompany this application

The following optional attachments may also be submitted: ( ) Survey Plat, scaled no more than 1 inch = 60 feet
Place an (X) beside whichever is submitted if applicable (X) Custom Site Plan, scaled no more than 1 inch = 60 feet

Applicant Information: (PRINT CLEARLY)

Applicant Name: Hyde Homes LLC Address: 129 Whisper Pine Rd. Zip: 28625
Applicant Email: joehyde@bellsouth.net Phone: 704-201-9935 Alt. Phone: _____
Owner Name: Walter + Christina Little Address: 172 Compton Park Rd. Zip: 28677
Owner Email: _____ Phone: _____ Alt. Phone: _____

Property Information:

Street Address: 172 Compton Park Rd. Statesville NC 28677
Subdivision Name: N/A Section/Phase: _____ Lot Number: _____
Driving Directions: Center St. (R) onto Old Mtn. Rd. (R) onto Compton Park House on (R)

Site Development Information: *(check or complete ALL that apply*

CHECK FOUNDATION TYPE

( ) New Single Family Residence — Maximum Number of Bedrooms: 3 — ( ) Crawl Space Foundation
( ) New Multi-Family Residence — Maximum Number of Occupants: _____ — (✓) Concrete Slab Foundation
( ) Accessory Building — ( ) Swimming Pool — ( ) Basement with Plumbing
( ) Bedroom(s) Addition — (✓) Other Addition/Structure: Pool House — ( ) Basement without Plumbing
( ) Repair to failing septic system ___ Tank ___ Drain lines Describe Problem: _____
Non-Residential Site Development: Type of Business: _____
Square Footage of Building: _____ Max. Number of Employees: _____ Max. Number of Seats/Beds/Other: _____

Water Supply: ( ) Replacement Well – Reason: _____
( ) Multi-connection Well Number of Houses: _____ Number of Persons: _____
( ) New Well (✓) Existing Well ( ) Community Well ( ) City Water ( ) Other Public Water

Desired Septic System Type: *(you may rank in order of preference)* Year existing system installed: _____
( ) No Preference ( ) Alternative ( ) Conventional ( ) Innovative ( ) Modified Conventional (✓) Other: Move repair area

Please answer the following to the best of your ability:

( ) Yes (✓) No Does the site contain any jurisdictional wetlands?
( ) Yes (✓) No Is any non-domestic sewage (i.e. industrial) to be generated?
( ) Yes (✓) No Is the site subject to approval by any other public agency?

I have read this application and certify that the information provided herein is true, complete, and correct. Authorized county and state officials are granted right of entry to conduct necessary inspections to determine compliance with applicable laws and rules. I understand that I am solely responsible for the proper identification and labeling of all property lines and corners and making the site accessible so that a complete site evaluation can be performed.

Signature: Jamie Hert, Hyde Homes LLC 5-23-18
Property owner or owner's legal representative signature (SIGNATURE REQUIRED) DATE

DOCUMENTATION TO AUTHORIZE AN OWNER'S LEGAL REPRESENTATIVE

Applications for permits require the "signature of the owner or owner's legal representative" (15A NCAC 18A .1937). If the owner does not sign the application himself or herself, they can submit any one of the following documents to designate their legal representative:

Power of Attorney; Real Estate Contract; Estate executor; Bankruptcy trustee; Court ordered guardianship

In the absence of the above documentation, the property owner may provide the local health department with documentation that designates a legal representative. A property owner may:

Complete this form to document his or her legal representative, or provide his or her own form that contains the information in this form.

If there are multiple property owners, then all property owners must sign the form that designates a legal representative.

By signing a form that designates a legal representative for purposes of 15A NCAC 18A .1937, the property owner authorizes that representative to act on their behalf in matters pertaining to the application and permitting process, including signing or receiving any application, document or permit. The owner retains full responsibility to meet all permit conditions specified by the local health department.

I, Walter and Christina Little, am the legal owner(s) of the property located at 172 Compton Park Rd Statesville NC 28677, identified as PIN (Parcel Identification Number) 4722455205, located in Iredell County, North Carolina.

Walter and Christina Little 5-23-18
Signature of Owner(s) Date

I do hereby authorize (**print legal representative/company name**) Hyde Homes LLC, to act as an agent on my behalf in applying for/signing/obtaining any of the documents described below.

- Application for Improvement Permit (IP) / Authorization to Construct (AC)
- Improvement Permit (IP) / Authorization to Construct (AC)
- Application for soil-site evaluation (new/repair)
- Application/permit for private drinking water well/well abandonment
- Application for Compliance Inspection

I agree to abide by all decisions and/or conditions between the legal representative acting on my behalf and the Iredell County Department of Public Health, Environmental Health Division.

Please return this signed form to the appropriate office:

Mooresville - Environmental Health
ronda.hart@co.iredell.nc.us
Fax: 704-662-3239
610 E. Center Avenue, Mooresville, NC 28115

Statesville - Environmental Health
adrienne.shea@co.iredell.nc.us
Fax: 704-871-3483
349 N. Center Street, Statesville, NC 28677


IREDELL COUNTY DEPARTMENT of ENVIRONMENTAL HEALTH

SITE PLAN WORKSHEET

SEE THE "SAMPLE SITE PLAN" BELOW. *INCOMPLETE SITE PLANS WILL BE RETURNED TO YOU FOR COMPLETION AND MAY RESULT IN A DELAY IN THE ISSUANCE OF YOUR SEPTIC SYSTEM OR WELL PERMIT!!!*

Place an (X) beside each item as you complete the site plan:

- ( ) Property Line measurements are clearly identified
- ( ) All proposed structures are indicated
- ( ) Front and side setbacks from property line
- ( ) Preferred driveway location
- ( ) Preferred well location
- ( ) Preferred septic system location
- ( ) North arrow, or other sufficient indicator of direction

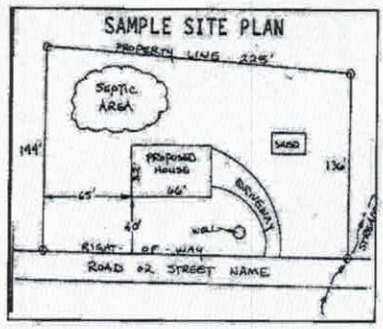


Circle N/A on the following if appropriate:

Location of septic systems and wells within 100' of your property	N/A
Location of easements and rights of ways on your property	N/A
Location of any designated wetlands on the property	N/A

USE THIS SPACE TO DRAW YOUR SITE PLAN

Show: proposed house or business footprint, wells, water lines, patios, pools and decks, and any other item that will occupy space on the site

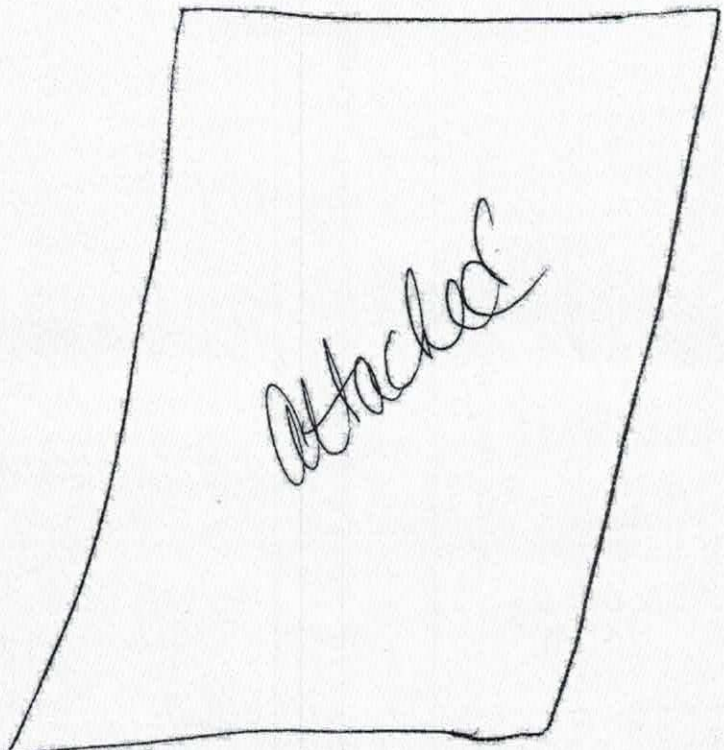

Signature: Jamie Hyde - Hyde Homes LLC — 5-24-18

Property owner or owner's legal representative signature (SIGNATURE REQUIRED) — DATE

IREDELL COUNTY HEALTH DEPARTMENT

Statesville Office (704) 878-5305 Mooresville Office (704) 660-3625 PERMIT # 20183

IMPROVEMENT PERMIT / AUTHORIZATION TO CONSTRUCT / OPERATION PERMIT / EXISTING SYSTEM

PIN # 4722357222

APPLICANT: Joshua Singleton APPLICANT ADDRESS: 138 Chuck Ln Union Grove NC

SITE ADDRESS: 172 Compton Park Statesville NC 28677 PHONE: 704-735-7500 ALT. PHONE: N/A

SITE DIRECTIONS: Buffalo Shoals Rd T/L Old Mtn Rd T/R Compton Park Lot on right

SUBDIVISION: N/A SECTION: N/A LOT # N/A LOT AREA: 0.857ac DESIGN FLOW: 360 L.T.A.R.: 0.25

Septic Tank 1000 (gal) STB Date

Pump Tank (gal) PT Date

Pump Make Model Serial #

Nitrification Fields 1 # Lines 6 Linear Ft: 360

Trench Width 36" Max. Trench Bottom Depth 36" Gravel Depth N/A

☐ New System ☐ Repair ☐ Expansion System Type: I II ☒ IV V VI

System Description: 25% Reduction

Repair System Description: 50% Reduction

Maintenance Agreement Required: ☐ YES ☒ NO

☒ GRAVITY ☐ PRESSURE

☒ Residence No. Bedrooms 3

☐ Business No. Persons 6

☐ Other No. Employees

☐ Slab ☒ Crawl Space

☐ Basement w/plumbing ☐ Basement w/o plumbing


Water Supply: ☒ Private ☐ Public ☐ Community

Comments / Conditions: Install 25% reduction on conventional with serial distribution. Ampi crush & fill existing tank & abandon well. Make CAB


ISSUED *

Purpose of this septic system permit is to relocate

INITIAL SITE SKETCH

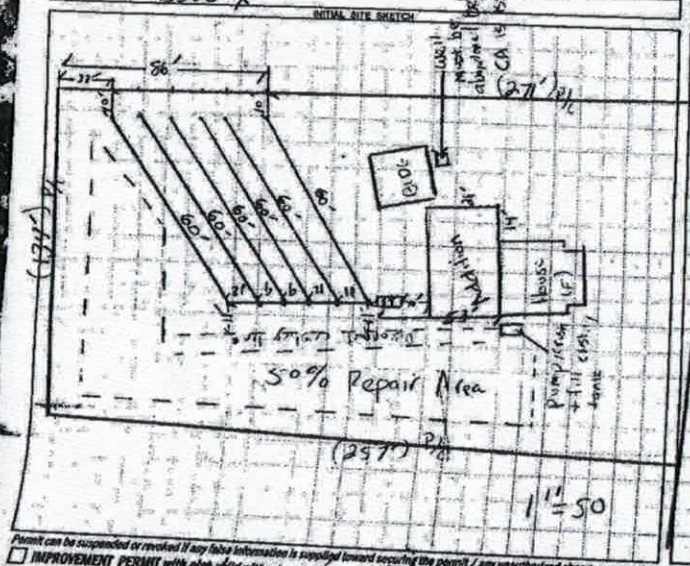

AS BUILT SKETCH

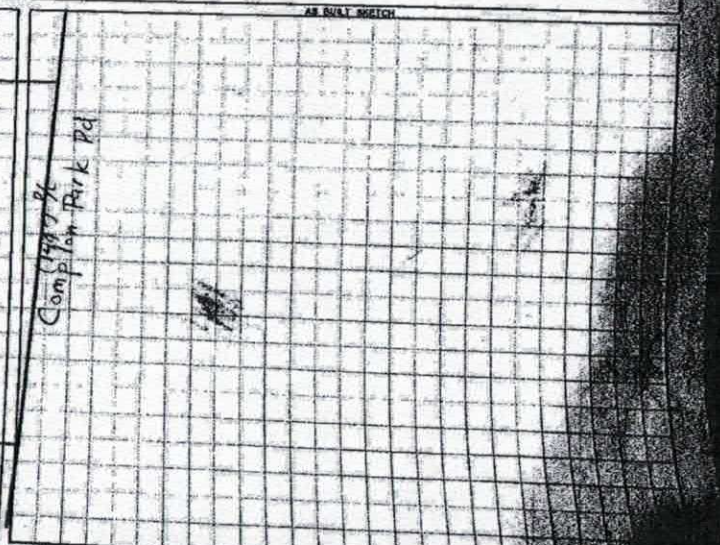

Permit can be suspended or revoked if any false information is supplied toward securing the permit / any unauthorized changes are made to the site / any unauthorized changes are made in the installation of the system. CONTACT A LOCATOR BEFORE YOU DIG


☐ IMPROVEMENT PERMIT with plat, valid without expiration ☒ IMPROVEMENT PERMIT with site plan valid for 60 mos. ☒ AUTHORIZATION TO CONSTRUCT valid for period equal to IMPROVEMENT PERMIT

Owner / Applicant Signature: Date: 11-27-15 Installed by:

IMPROVEMENT PERMIT by: Date: 04/26/15 OPERATION PERMIT by:

AUTHORIZATION TO CONSTRUCT by: Date: 06/02/15 Existing System Ins

Health Dept. Copy - WHITE Applicant (Final Approval) - YELLOW Applic

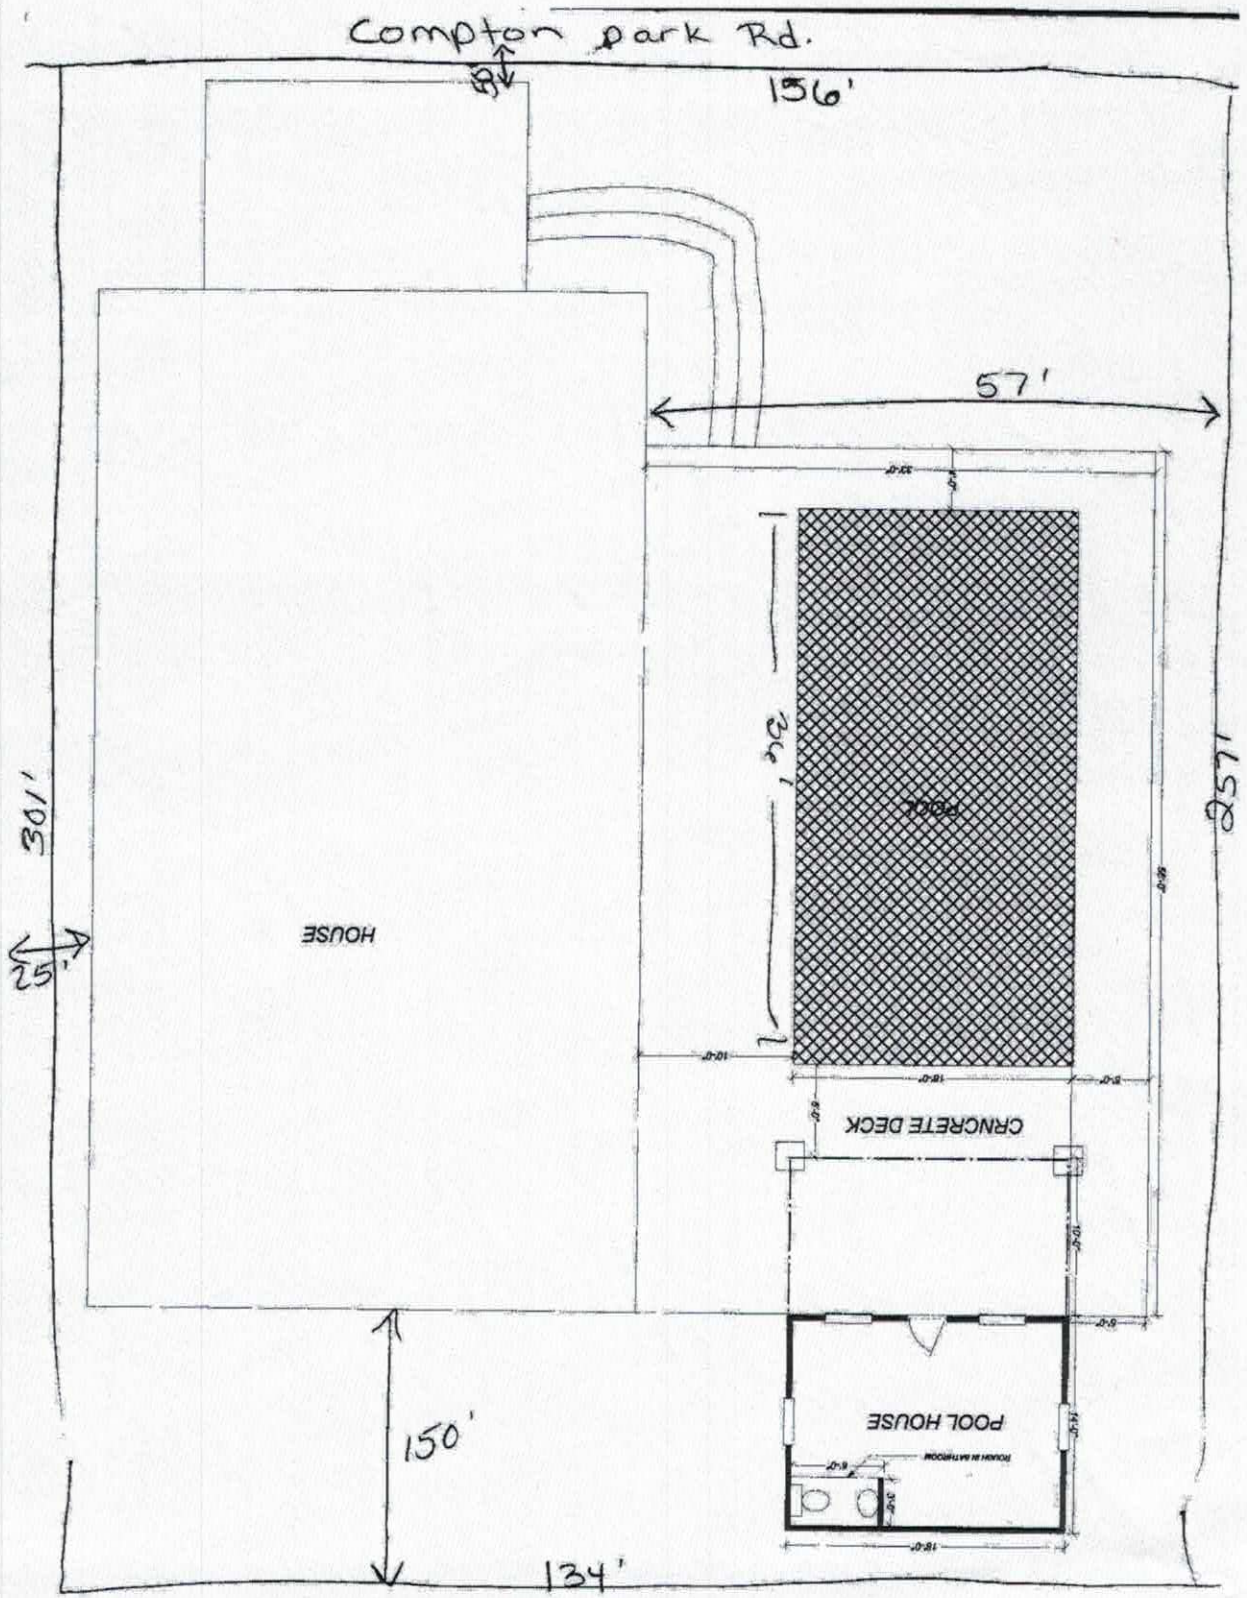
Compton park Rd.
156'
57'
25'
HOUSE
POOL
CRNCRETE DECK
POOL HOUSE
150'
134'

IREDELL COUNTY

PO Box 788
349 North Center St.
Statesville, NC 28677

APPLICATION NUMBER
235957
Issue Date: 05/24/2018

ZONING PERMIT

Parcel Number	Street Address	Jurisdiction
4722357222.000	172 COMPTON PARK, STATESVILLE, NC 28677	

Owner Information	Applicant Information
Owner: LITTLE FRED E+KATHY W	Applicant: HYDE HOMES LLC
Address: 166 COMPTON PARK RD	Address: 129 WHISPER PINES RD
STATESVILLE, NC 28677	STATESVILLE, NC 28625
Phone:	Phone: 704-201-9935

Use Requested	Zone Code
POOL HOUSE -WILL NEED TO MOVE REPAIR AREA FOR IT AND POOL TH AT WILL BE PULLED AT A LATER DATE	

Lot Acreage	F Setback	B Setback	L Setback	R Setback	Watershed	Flood Zone
31.826		10.00	10.00	10.00	PACL	

Remarks:

BEHIND FRONT BUILDING LINE OF PRINCIPLE STRUCTURE


Accessory Structures: Must meet requirement R1 of the LDC. Shall not be erected in front building line of the principal structure or within 25 Æ of a side street on a corner lot. Shall not be erected within 10 Æ of any line not a street line or within 10 Æ of any other building on the same lot. Shall not be erected within the 50 Æ buffer zone of lake lots. Shall not exceed the height limitation of the principal structure. Exceptions to the front building line location: 1.If the lot is 1 acre or greater and the location of the structure is at least 150 Æfrom the frontage street right of way line then the structure can be located in front of home or 2.Is a double frontage lake lot. Any accessory building or structure over 2000 sq/ft shall be setback a minimum of 30 Æ from any property line. Metal carports not exceeding 400 sq/ft are allowed in the front yard provided they meet the front setback requirement of the principal structure.

The applicant certifies that there are no deed restrictions, contractual agreements or governmental regulations of any kind that interfere with or prohibit the use of the property or the use for which this permit is requested. The applicant further acknowledges that enforcement of deed restrictions, plat conditions and other contractual agreements will not be undertaken by Iredell County and is the sole responsibility of the affected parties.

Applicant: _____ Date: _____

Permit Number	140106	TOTAL FEES:	$ 77.25

ZONING DISCLAIMER

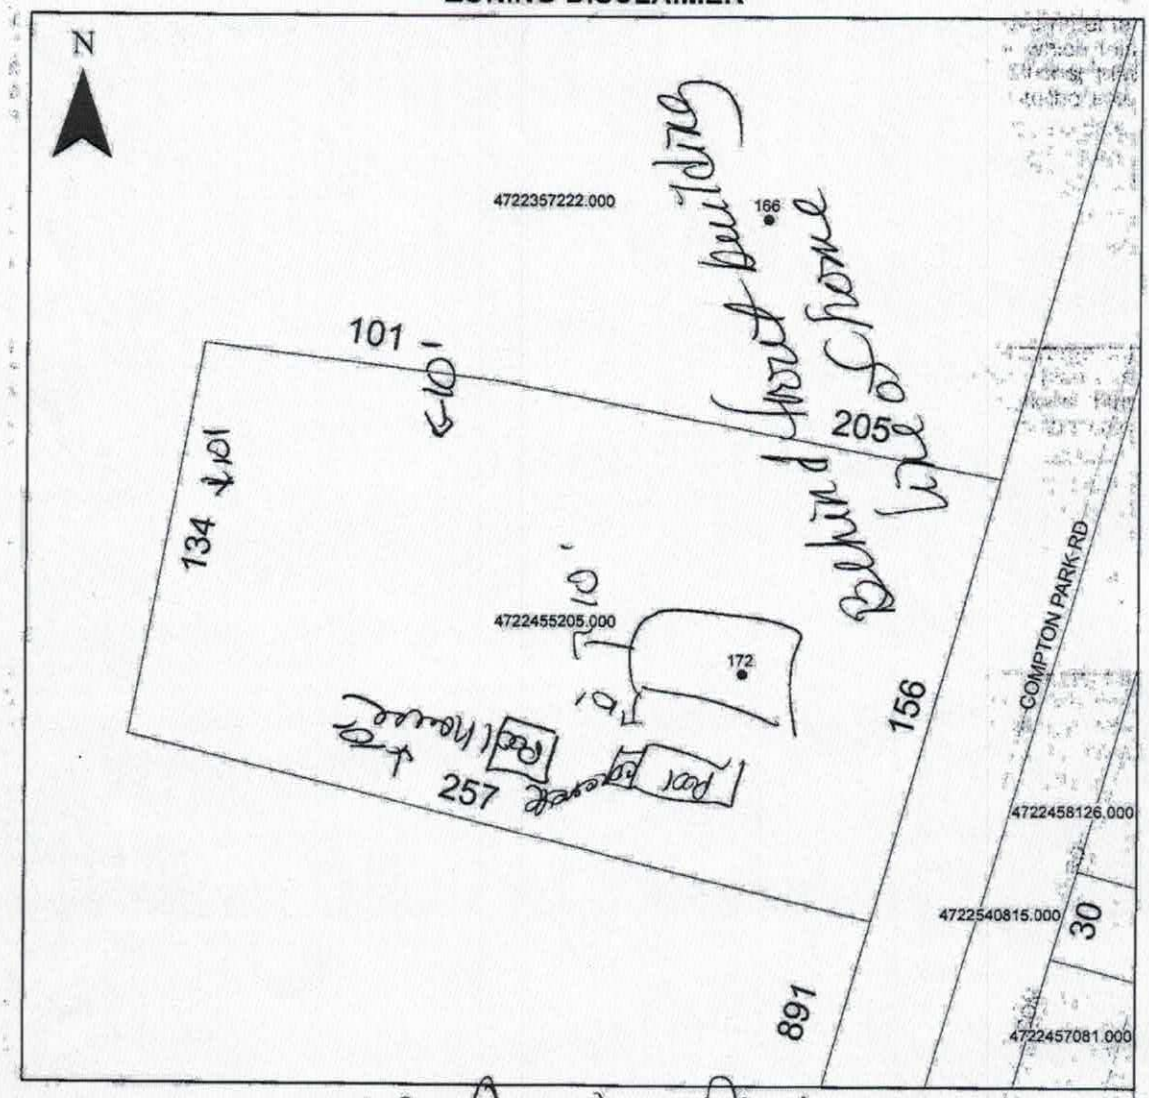

Property Address 172 Compton Park

The applicant certifies that there are no deed restrictions, contractual agreements or governmental regulations of any kind that interfere with or prohibit the use of the property or the use for which this permit is requested. Applicant further acknowledges that the enforcement of deed restrictions, plat conditions, and other contractual agreements will not be undertaken by Iredell County and is the sole responsibility of the affected parties.

Applicant

Date