IREDELL COUNTY HEALTH DEPARTMENT

STATESVILLE 704-878-5305 MOORESVILLE 704-664-5281

IMPROVEMENT PERMIT / AUTHORIZATION TO CONSTRUCT / OPERATION PERMIT / EXISTING SYSTEM INSPECTION

PERMIT# 101946 PIN# 4722-46-7036 DATE 9/17/01

OWNER OR CONTRACTOR Mountain Road Baptist Church PHONE: Business 704 528-6648 Home

ADDRESS 132 Compton Park Rd Statesville NC 28677

LOCATION Hwy 21N, TL Old Mt. Rd, TL Compton Park on Rt.

SUBDIVISION BLOCK / SECTION LOT LOT AREA SITE CLASS PS DESIGN FLOW 750 L.T.A.R. 0.3

Septic Tank: ~~1200 Existing~~ Gallons: STB Date

Pump Tank: Gallons: PT Date

Pump Make: Model Serial No.

Nitrification Field: No Fields 1 Square Feet 1875 Linear Feet 625

No Lines 5@125' Trench Width 36" Max Trench Bottom Depth 36" Gravel Depth —

☒ New System ☐ Repair System Type: I, II, (III), V, V, VI

System Description: Gravity 25% Reduction

Repair System Description: 50%

Maintenance Agreement Required: ☐ Yes ☒ No

☐ Slab ☐ Crawl Space ☐ Basement w/plumbing ☐ Basement wo/plumbing

☐ House/Mod. Home No. Bedrooms

☐ Mobile Home No. Bathrooms

☐ Business No. Employees

☐ Other Church 250 seats


Water Supply: ☒ Individual ☐ Public ☐ Community

Comments/Conditions: Abandon existing Bed system


Abandoned ea 11/13/01

Comments/Conditions: - Septic Tank Monitor Installed
- Installed 20 Bio diffuser chambers/line (100 total)

INITIAL SITE SKETCH

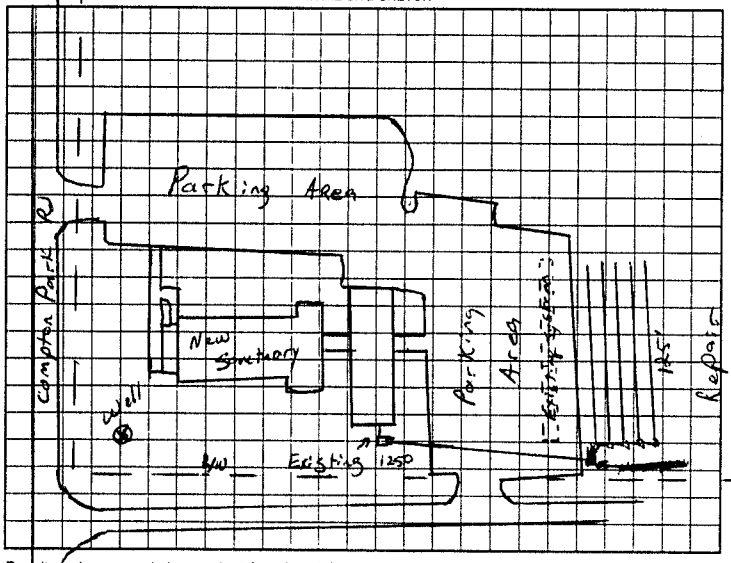

AS BUILT SKETCH

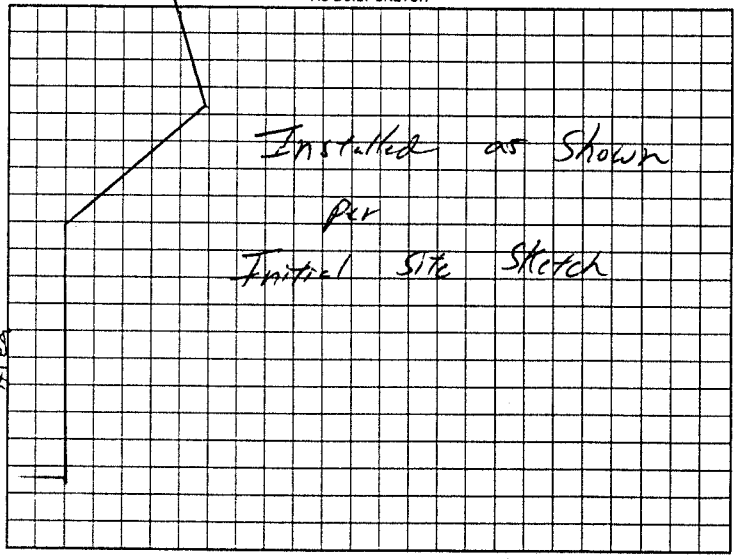

Permit can be suspended or revoked if any false information is supplied toward securing the permit/any unauthorized changes are made to the site/any unauthorized changes are made in the installation of the system. Improvement Permit with plat valid without expiration. Improvement Permit with site plan valid for sixty months. Authorization to Construct is valid for a period equal to that of Improvement Permit – not to exceed sixty months.

Signed: James Hodge date 10-5-01 Installed by: James Hudek

Improvement Permit by: RST date 9/17/01 Operation Permit by: William O Johnson date 11/13/01

Authorization to Construct by: RST date 9/17/01 Existing System Inspection by: date

HEALTH DEPT COPY: WHITE OWNER COPY (FINAL) YELLOW OWNER COPY (INITIAL) PINK