IREDELL COUNTY HEALTH DEPARTMENT

Statesville Phone TR 3-7271

Mooresville Phone NO 3-1271

PERMIT TO INSTALL SEPTIC TANK

Permit NO. _____

Permit Date Nov. 2 1959

Owner C. P. Brady Builder Address Kyles X Rds

Installed By CLYDE HOKE Address


Location of Property Old mnt. Rd. & Bamian Springs 2nd brick on R before X Rd.

Tank		Capacity		Length of Lines		Fixtures	
Block	( )	800	( )	150'	(4)	No. of Baths	( )
Precast	(4)	900	(4)	175'	( )	Dishwasher	( )
		1000	( )	200'	( )	Garbage Grdr.	( )
		1100	( )	225'	( )	Auto-Washer	( )
		1200	( )	250'	( )	Other	
		Other		Other			

NOTIFY HEALTH DEPARTMENT AT LEAST EIGHT HOURS BEFORE TANK IS TO BE INSPECTED.

Final Inspection _____ 195_ Approved ( ) Disapproved ( )

Remarks Selfgapt — not for wash — well 50'

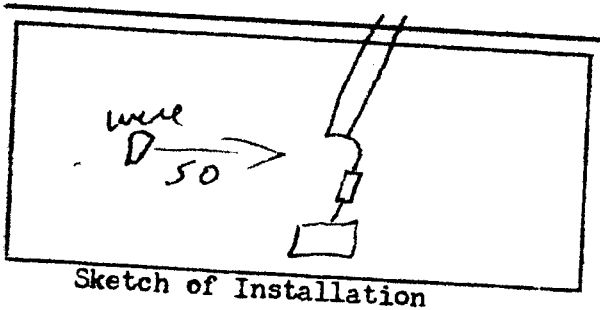

Sketch of Installation

Sanitarian