IREDELL COUNTY HEALTH DEPARTMENT

STATESVILLE 704-878-5305 MOORESVILLE 704-664-5281

IMPROVEMENT PERMIT / CERTIFICATE OF COMPLETION / OPERATION PERMIT / EXISTING SYSTEM INSPECTION

PROPERTY DESCRIPTION NO. D67009 DATE 7-31-97 TAX MAP NO. 4722470933 Watershed: ☐ Yes ☐ No

OWNER OR CONTRACTOR Alaine Harness / Gartner PHONE: Business _____ Home _____

ADDRESS 853 Old Mtn Rd Statesville

LOCATION I-40 To Old Mtn & Property on left after Buffalo shoals Cross Rds

SUBDIVISION _____ BLOCK / SECTION _____ LOT _____ LOT AREA _____ SITE CLASS. _____ DESIGN FLOW _____ L.T.A.R. _____

Septic Tank: 1000 Gallons; STB _____ Date _____

Pump Tank: Existing Gallons; PT _____ Date _____

Pump Make: _____ Model _____ Serial No. _____

Nitrification Field: No Fields 1 Square Feet _____ Linear Feet 150ft

No Lines 1 Trench Width 36 Max Trench Bottom Depth 36 Gravel Depth 1'0

☒ New System ☐ Repair System Type: I, II, III, IV, V, VI

System Description: Gravity Conventional

Repair System Description: _____

Maintenance Agreement Required: ☐ Yes ☐ No

☐ House/Mod. Home No. Bedrooms 4

☒ Mobile Home No. Bathrooms 2

☐ Business No. Employees ____

☐ Other _____

☐ Slab ☐ Crawl Space ☐ Basement w/plumbing ☐ Basement wo/plumbing

Water Supply: ☐ Individual ☐ Community ☐ Public


Comments: Original system sized for 3Bd adding one

Keep line on contour 9ft on center


check Tank and sanitary T replace if needed

Comments:

INITIAL SITE SKETCH

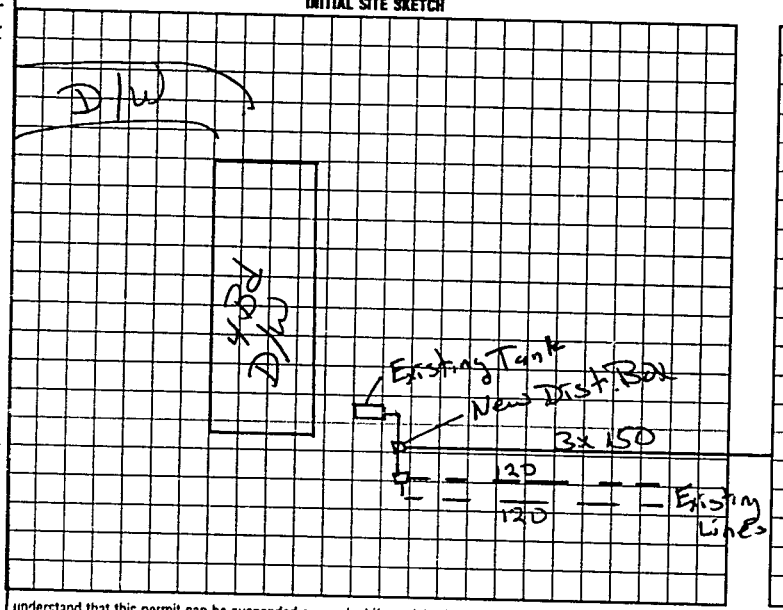

AS BUILT SKETCH

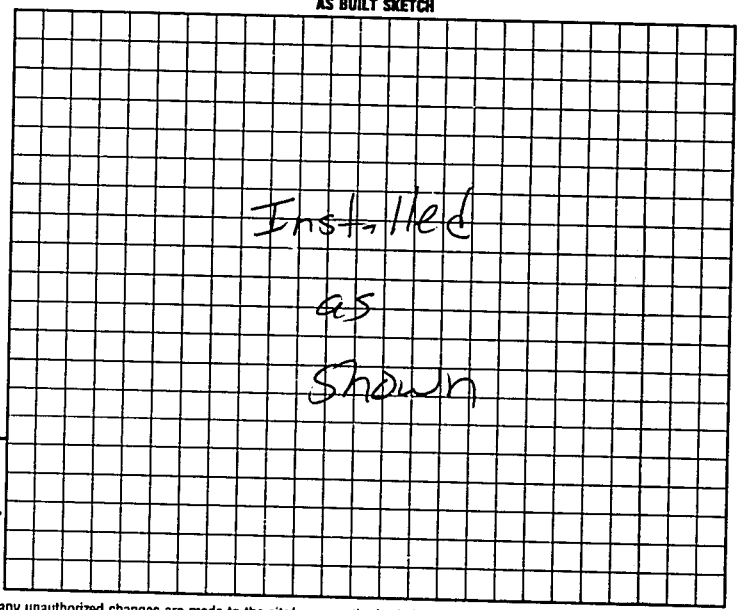

I understand that this permit can be suspended or revoked if any false information is supplied toward securing the permit/any unauthorized changes are made to the site/any unauthorized changes are made in the installation of the system. Improvement Permit is valid for 60 months from date of issuance.

Signed: _____

Improvement Permit by: Authorization to Construct Mark Cox RS date 8-1-97

Existing System Inspection by: Mark Cox RS date 8-1-97

Installed by: A-1

Certificate of Completion by: _____ date _____

Operation Permit by: Mark Cox RS date 8-28-97

HEALTH DEPT COPY: WHITE INSPECTION COPY (FINAL): GREEN OWNER COPY (FINAL): YELLOW INSPECTION COPY (INITIAL): PINK OWNER COPY (INITIAL): GOLD