I

06370

IREDELL COUNTY HEALTH DEPARTMENT

(SEPTIC TANK) IMPROVEMENTS PERMIT AND CERTIFICATE OF COMPLETION
(Ground Absorption Sewage Disposal System – G. S. Chapter 130-Article 13C)

OWNER OR CONTRACTOR CLARENCE HARTNESS DATE 4-30-87 PERMIT NO. _____

PHONE: Business _____ Home _____

LOCATION: Buffalo Shoals Rd. west - T.L. at Kyles Xing - appx. 1/4 mi. on Rt. S. R. No. _____

SUBDIVISION NAME _____ LOT NO. 19-25 SECTION OR BLOCK NO. _____

House ( ) Mobile Home (✓) Business ( ) Other _____

No. Bedrooms 3 No. Bathrooms 2

Garbage Disposal Unit Yes ( ) No (✓)

Auto. Dishwasher Yes (✓) No ( )

Auto. Wash. Machine Yes (✓) No ( )

Site Suitable Yes (✓) No ( )

Lot Area 175' X 492'

Character & Porosity of Soil Appr. Suitable


Percolation Rate 1 gal/sq. ft.

Topography 2-6% slope

Depth to Water Table 10'+

Rock or other impervious formations None observed in area system was installed

_____ Basement with Plumbing _____ Basement without Plumbing ✓ No Basement

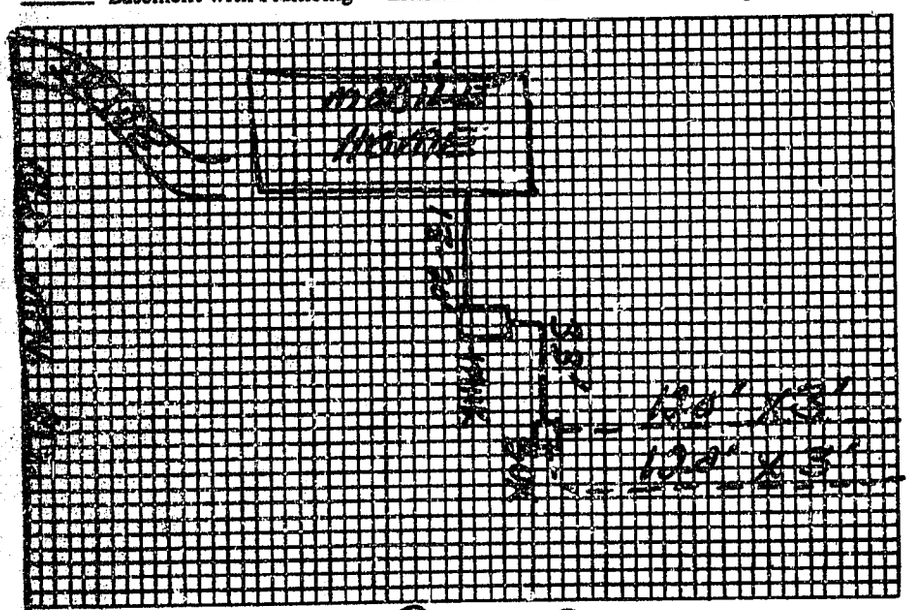

Plot of System

Size of Tank 1000 Gals.

Nitrification Field:
No. of Lines 2
Sq. Ft. 720 Linear Ft. 240
Depth of Stone in Lines 12"

Water Supply: Individual (✓)
Public ( )

Installed by Sam Ostwalt

I understand and agree to install septic tank system as specified on this Improvements Permit.

Signed: _____

IMPROVEMENTS PERMIT BY Steve Brown

COMMENTS: _____

CERTIFICATE OF COMPLETION BY Steve Brown DATE 4-30-87

EXISTING SYSTEM CHECKED BY: _____ DATE _____

CONSTRUCTION MUST COMPLY WITH ALL OTHER APPLICABLE STATE AND LOCAL REGULATIONS.

Permit is VOID if any unauthorized changes are made in installation of system and/or if any false information is supplied in making Improvements Permit.

Health Dept. Copy: White Inspection Dept. Copy: Yellow Sanitarian's Copy: Pink Owner's Copy: Gold