IREDELL COUNTY HEALTH DEPARTMENT

STATESVILLE 704-878-5305 MOORESVILLE 704-664-5281

IMPROVEMENT PERMIT / AUTHORIZATION TO CONSTRUCT / OPERATION PERMIT / EXISTING SYSTEM INSPECTION

PERMIT# 76387 PIN# 4722 48 0703

OWNER OR CONTRACTOR Billy Little PHONE: Business 871-2015 Home DATE 9-16-98

ADDRESS PO Box 1289 Troutman N.C.

LOCATION Dirt rd on RJ Turner Rumple Dr. below Kyles Road Tb St Joseph Rd

SUBDIVISION Lippard Sp BLOCK / SECTION LOT 73 LOT AREA 1.65 acres SITE CLASS. PS DESIGN FLOW 360 L.T.A.R. 137

Septic Tank: 1000 Gallons; STB 794 Date 10-6-98

Pump Tank: Gallons; PT Date

Pump Make: Model 1125 Serial No.

Nitrification Field: No Fields 1 Square Feet 375 Linear Feet 375

No Lines 4 Trench Width 36" Max Trench Bottom Depth 36" Gravel Depth 12"

☑ New System ☐ Repair System Type: I, II, III, IV, V, VI

System Description: Conv. Gravity

Repair System Description: Pump to 25% rule

Maintenance Agreement Required: ☐ Yes ☐ No

☑ House/Mod. Home No. Bedrooms 3

☐ Mobile Home No. Bathrooms 2

☐ Business No. Employees

☐ Other


☐ Slab ☑ Crawl Space ☐ Basement w/plumbing ☐ Basement wo/plumbing

Water Supply: ☑ Individual ☐ Public ☐ Community


Comments:/Conditions:

Comments:/Conditions:

INITIAL SITE SKETCH

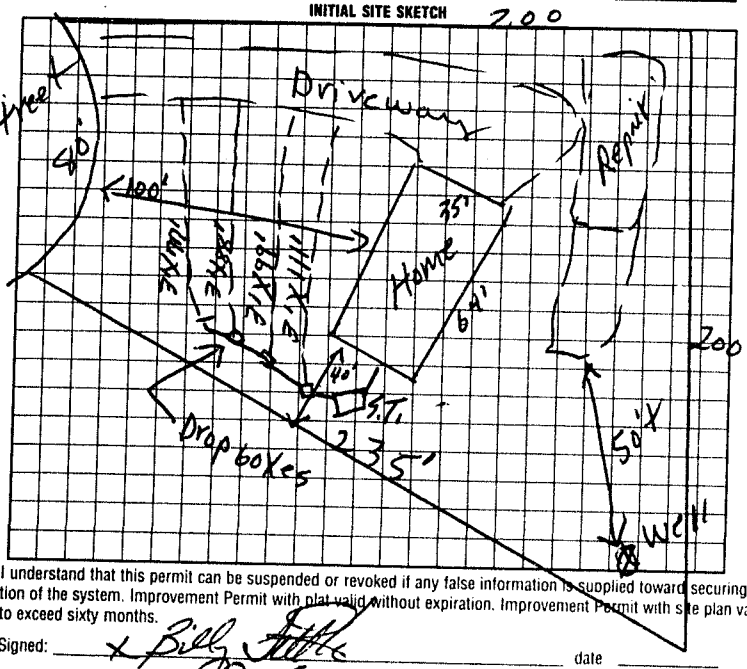

AS BUILT SKETCH

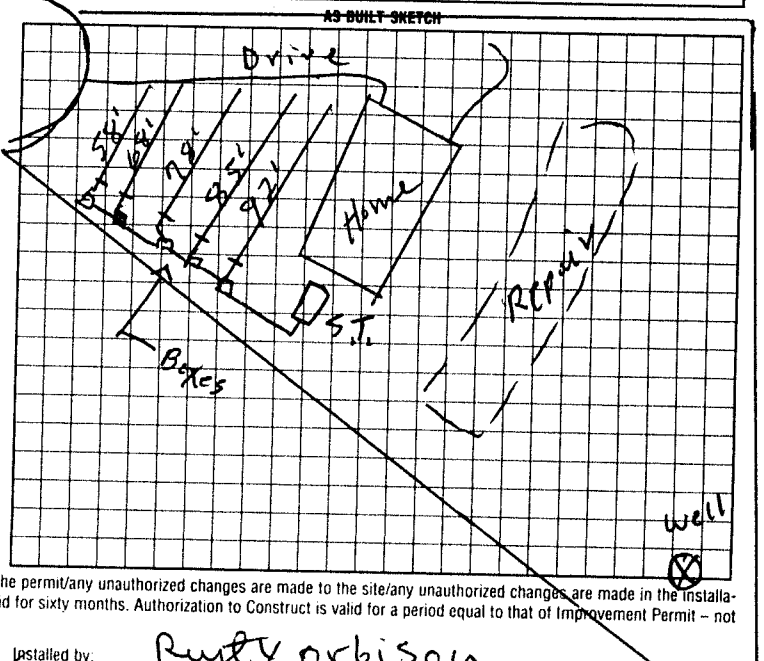

I understand that this permit can be suspended or revoked if any false information is supplied toward securing the permit/any unauthorized changes are made to the site/any unauthorized changes are made in the installation of the system. Improvement Permit with plat valid without expiration. Improvement Permit with site plan valid for sixty months. Authorization to Construct is valid for a period equal to that of Improvement Permit – not to exceed sixty months.

Signed: x Billy Little date

Improvement Permit by: R. C. Moore date 9-16-98

Authorization to Construct by: R. C. Moore date 9-16-98

Installed by: Rusty Orbison

Operation Permit by: R. C. Moore date 2-4-99

Existing System Inspection by: date

HEALTH DEPT. COPY: WHITE INSPECTION COPY (FINAL): GREEN OWNER COPY (FINAL) YELLOW INSPECTION COPY (INITIAL) PINK OWNER COPY (INITIAL): GOLD