Site Address: 374 Troutman Farm Rd, Stat.

IREDELL COUNTY HEALTH DEPARTMENT

STATESVILLE 704-878-5305 MOORESVILLE 704-664-5281

IMPROVEMENT PERMIT / AUTHORIZATION TO CONSTRUCT / OPERATION PERMIT / EXISTING SYSTEM INSPECTION

PERMIT# 150395 PIN# 4722 500 164 1216 DATE 11-6-08

OWNER OR APPLICANT ROBERT EUDY PHONE: Business 704-400-8450 Home 704-528-4838

ADDRESS 451 TROUTMAN Farm Rd Statesville NC 28677

LOCATION ONE WEST @ TROUTMAN FARM ON RT ACROSS FROM Historic barnyard

SUBDIVISION ____ BLOCK / SECTION ____ LOT ____ LOT AREA 10 ACRES SITE CLASS. PS DESIGN FLOW 360 L.T.A.R. 1.3

Septic Tank: 1000 Gallons: STB 825 Date 9/2/16

Pump Tank: ____ Gallons: PT ____ Date ____

Pump Make: ____ Model ____ Serial No. ____

Nitrification Field: No Fields 1 Square Feet EB=1700 Linear Feet 300

No Lines 3X100' Trench Width 36" Max Trench Bottom Depth 36"

☒ New System ☐ Repair ☐ Expansion System Type: I II III IV V VI

System Description: GRAVITY 25% REDUCT

Repair System Description: PUMP 25% REDUCT

Maintenance Agreement Required: ☐ Yes ☒ No

☒ House/Mod. Home No. Bedrooms 3

☐ Mobile Home No. Persons ____

☐ Business No. Employees ____

☐ Other ____

Water Supply: ☒ Individual ☐ Public ☐ Community

Gravel Depth N/A ☒ Gravity ☐ Pressure ☐ Slab ☒ Crawl Space ☐ Basement w/plumbing ☐ Basement wo/plumbing

Comments/Conditions: ① RAKE AND LIME TRENCH WALLS DUE TO SMEARING AND WET FLAKES ② Install Lines On Centers AND MAINTAIN SETBACKS ③ SEE Comments ON PERMIT. ④ Keep WELL 100' AWAY FROM

Comments/Conditions: SYSTEM AND REPAIR.

INITIAL SITE SKETCH

SEE ATTACHED SYSTEM DESIGNED BY LORNE COOK, P.E.

AS BUILT SKETCH

Permit can be suspended or revoked if any false information is supplied toward securing the permit/any unauthorized changes are made to the site/any unauthorized changes are made in the installation of the system. Improvement Permit with plat valid without expiration ☐ Improvement Permit with site plan valid for sixty months ☒ Authorization to Construct is valid for a period equal to that of Improvement Permit – not to exceed sixty months.

Signed: Robert E. Eudy date 12/11/08

Improvement Permit by: [signature] date 11-6-08

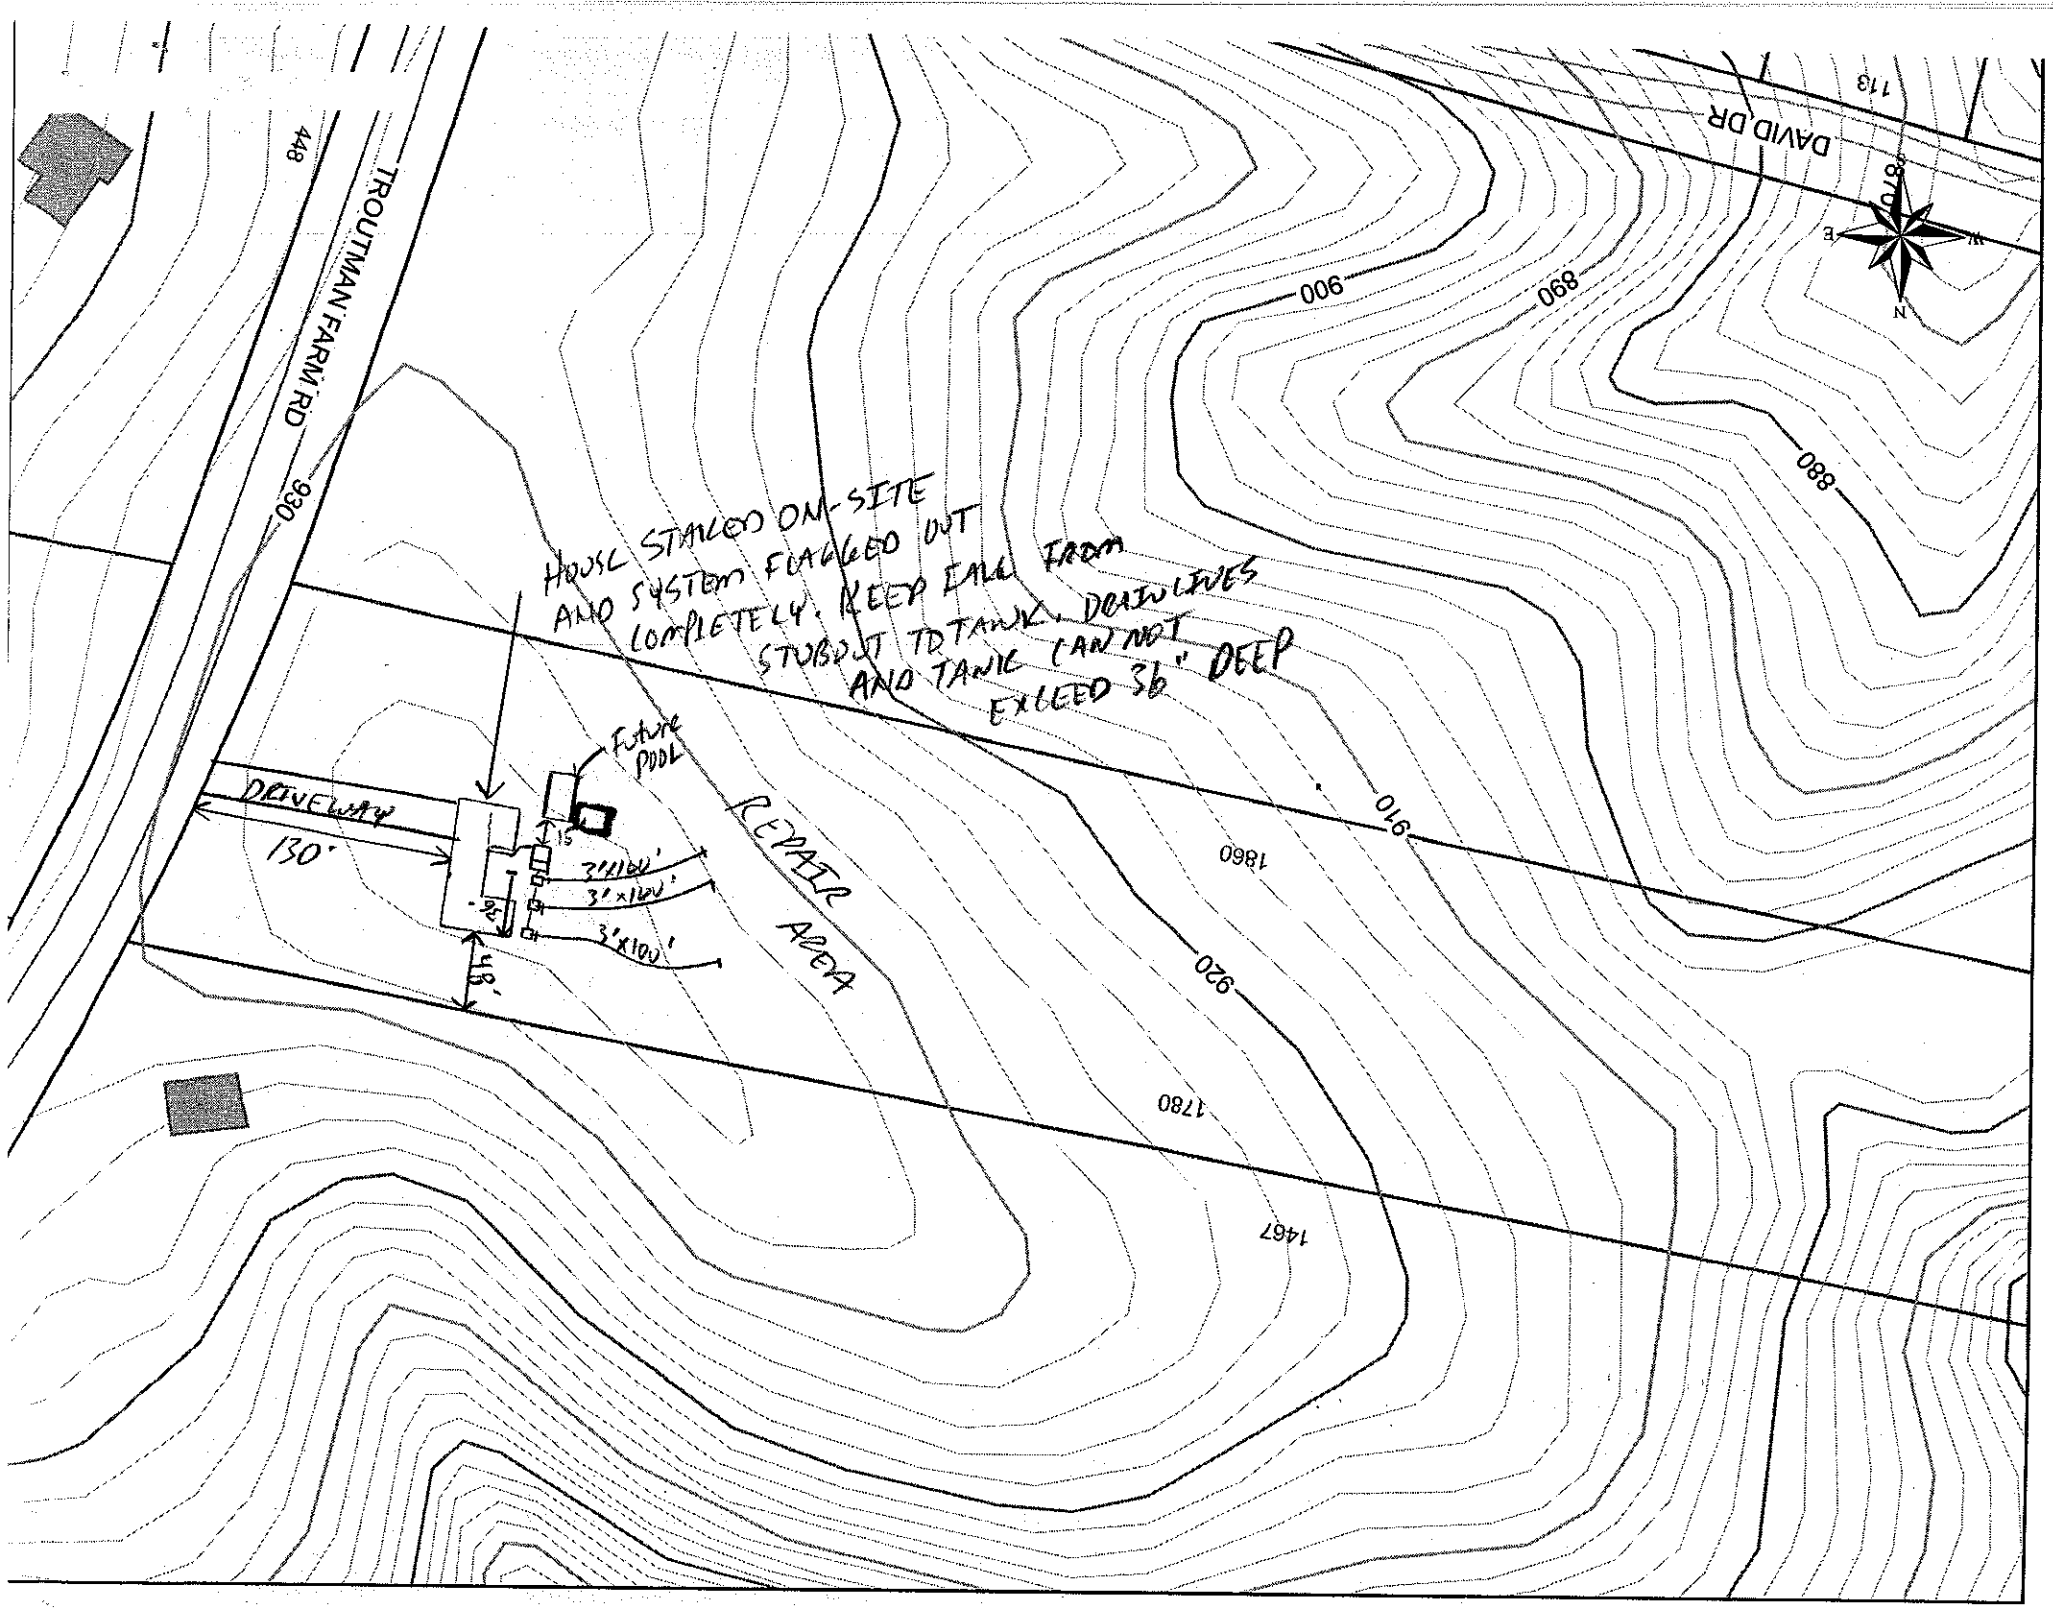
Authorization to Construct by: [signature] date 11-6-08

Installed by: Rowan Septic Tank

Operation Permit by: [signature] date 10/24/16

Existing System Inspection by: ____ date ____

HEALTH DEPT. COPY: WHITE OWNER COPY (FINAL): YELLOW OWNER COPY (INITIAL): PINK


TROUTMAN FARM RD
DAVID DR
448
630
900
880
910
920
1780
1467
1860
HOUSE STACKED ON-SITE AND SYSTEM FLAGGED OUT COMPLETELY. KEEP EAST FROM STUBOUT TO TANK. DRAIN LINES AND TANK CAN NOT EXCEED 36" DEEP
Future POOL
DRIVEWAY
130'
REPAIR AREA
3'x16U'
3'x12U'
3'x10U'
48'
N
E
W