5

IREDELL COUNTY HEALTH DEPARTMENT

Statesville Office (704) 878-5305 Mooresville Office (704) 660-3625

IMPROVEMENT PERMIT / AUTHORIZATION TO CONSTRUCT / OPERATION PERMIT / EXISTING SYSTEM

PERMIT # 215684

APPLICANT: Kate Rumple

PIN # 4722-54-0815.000

SITE ADDRESS: 175 Compton Park Rd. Statesville NC 28677

APPLICANT ADDRESS: 721 Old Mountain Rd. Statesville NC 28677

SITE DIRECTIONS: Old Mountain Rd. to Compton Park, Site on L (Last Drive Before Kyles Oak Dr.)

PHONE: 704-437-6294 ALT. PHONE: 704-397-7293

SUBDIVISION: —

SECTION: — LOT # Tract 4 LOT AREA: 4.161 Acre


DESIGN FLOW: 480 GPD. L.T.A.R.: .275 I / .225 R

Septic Tank	1000	(gal)	STB	760	Date	1-9-16	☒ New System	☐ Repair	☐ Expansion	System Type: I II III IV V VI	
Pump Tank	N/A	(gal)	PT	N/A	Date	N/A	System Description:	25% Reduction - Gravity (w Cover)			
Pump Make	N/A	Model	Poly Flo		Serial #	PL-68	Repair System Description:	25% Reduction - Gravity.			
# Nitrification Fields	1	# Lines	4 @ 110'		Linear Ft:	436'	Maintenance Agreement Required:	☐ YES	☒ NO		
Trench Width	36"	Max. Trench Bottom Depth	*20"*		Gravel Depth	N/A		☒ GRAVITY	☐ PRESSURE		

☒ Residence	No. Bedrooms	4	Water Supply
☐ Business	No. Persons	8	☒ Private
☐ Other	No. Employees		☐ Public
☐ Slab	☐ Crawl Space		☐ Community
☒ Basement w/plumbing			☐ Basement w/o plumbing

Comments / Conditions: Install 436' of Drainfield As Shown.
Drainfield will Require 1"-2" Additional Cover to Make 6" Total Cover.
Remove Drainage Feature and Burm. Fill Drainage.
First Line is 44' from Property Line.
Future Barn To Be 50' from Any Property Line.

INITIAL SITE SKETCH

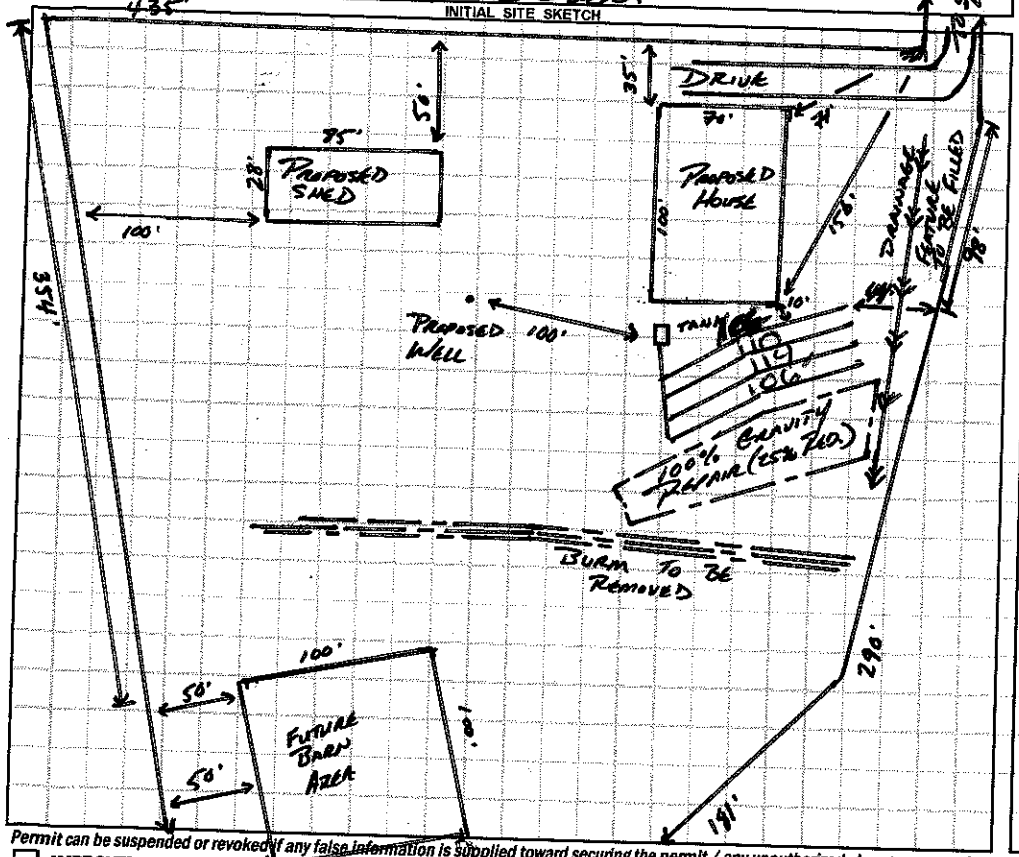

AS BUILT SKETCH

1" = 100'

Install Red Quik 4 as drawn

Permit can be suspended or revoked if any false information is supplied toward securing the permit / any unauthorized changes are made to the site / any unauthorized changes are made in the installation of the system. **CONTACT A LOCATOR SERVICE PRIOR TO ANY EXCAVATION**

☐ **IMPROVEMENT PERMIT** *with plat valid without expiration.*

☒ **IMPROVEMENT PERMIT** *with site plan valid for 60 mos.*

☒ **AUTHORIZATION TO CONSTRUCT** *valid for period equal to IMPROVEMENT PERMIT--not to exceed 60 mo.*

Owner / Applicant Signature: Kate Smith Date: 8-16-16

IMPROVEMENT PERMIT by: APPROVED DEC 28 2015 Date: 8/9/16

AUTHORIZATION TO CONSTRUCT by:

Installed by: T B Grading

OPERATION PERMIT by: Date: 10/20/16

Existing System Inspected by: Date:

Health Dept. Copy - WHITE Applicant (Final Approval) - YELLOW Applicant (Conditional Approval) - PINK