IREDELL COUNTY HEALTH DEPARTMENT

This PERMIT REPLACES PREVIOUS ISSUED 9-13-02

STATESVILLE 704-878-5305 (1) MOORESVILLE 704-664-5281

IMPROVEMENT PERMIT / AUTHORIZATION TO CONSTRUCT / OPERATION PERMIT / EXISTING SYSTEM INSPECTION

PERMIT# 107-684 PIN# 4722-56-0192 DATE 11-17-03

OWNER OR CONTRACTOR MARVIN ALAN NORMAN PHONE: Business 704-878-2376 Home 704-528-4835

ADDRESS 122 COMPTON PARK RD STATESVILLE, NC 28677

LOCATION BUFFALO SHOALS ROAD, TL OLD MOUNTAIN ROAD, TR COMPTON PARK ROAD 2ND & 3RD LOTS ON LEFT

SUBDIVISION A. RUMPLE BLOCK / SECTION ____ LOT 10 & 11 LOT AREA 250' x 296' SITE CLASS. PS DESIGN FLOW 480 L.T.A.R. 0.30 GPD/FT²

Septic Tank: 1000 Gallons; STB 1007 Date 11-10-03
Pump Tank: ____ Gallons; PT ____ Date ____
Pump Make: ____ Model ____ Serial No. ____
Nitrification Field: No Fields 1 Square Feet 1600 Linear Feet 540
No Lines SIX Trench Width 36" Max Trench Bottom Depth 36" Gravel Depth 12"

☑ New System ☐ Repair System Type: (I) II III IV V VI
System Description: CONVENTIONAL GRAVITY
Repair System Description: CONVENTIONAL PUMP
Maintenance Agreement Required: ☐ Yes ☑ No

☑ House/Mod. Home No. Bedrooms 4
☐ Mobile Home No. Bathrooms 3
☐ Business No. Employees ____
☐ Other ____


☐ Slab ☐ Crawl Space ☐ Basement w/plumbing ☑ Basement wo/plumbing

Water Supply: ☑ Individual ☐ Public ☐ Community
WELL


Comments:/Conditions:

Comments:/Conditions: SEPTIC TANK WITH RISER INSTALLED USING "TUFFITE" FILLER

INITIAL SITE SKETCH

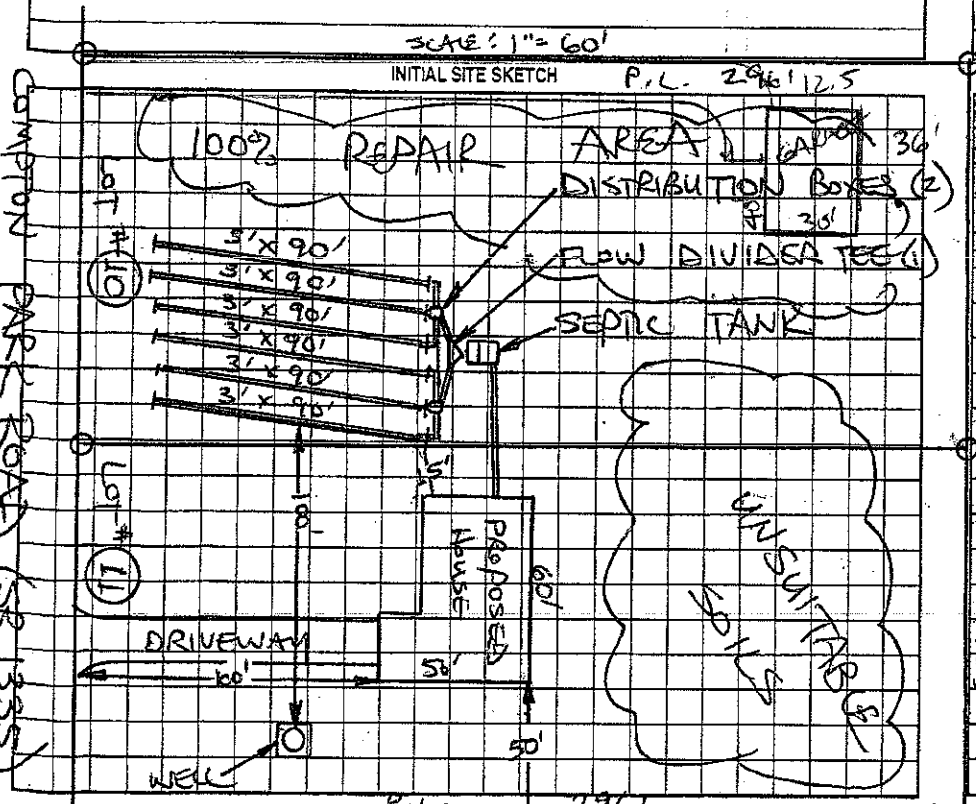

AS BUILT SKETCH

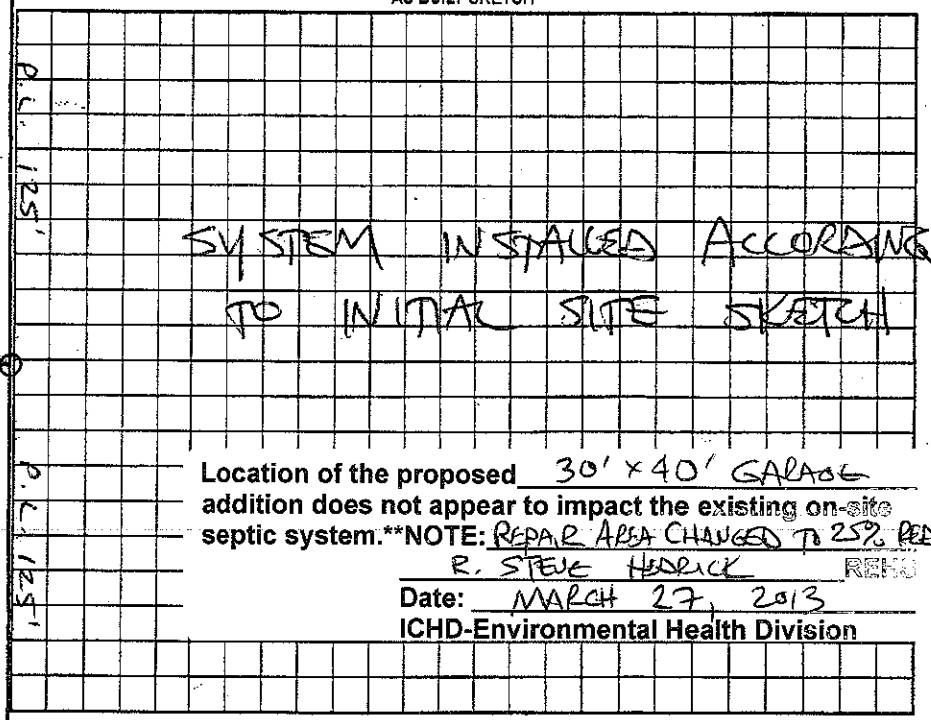

Location of the proposed 30' x 40' GARAGE **addition does not appear to impact the existing on-site septic system.**NOTE:** REPAIR AREA CHANGED TO 25% REDUCTION

R. STEVE HEDRICK REHS

Date: MARCH 27, 2013

ICHD-Environmental Health Division

Permit can be suspended or revoked if any false information is supplied toward securing the permit/any unauthorized changes are made to the site/any unauthorized changes are made in the installation of the system. Improvement Permit with plat valid without expiration. Improvement Permit with site plan valid for sixty months. Authorization to Construct is valid for a period equal to that of Improvement Permit – not to exceed sixty months.

Signed: ____ date 12/1/03

Improvement Permit by: STEVE HEDRICK date 11-17-03

Authorization to Construct by: STEVE HEDRICK date 11-17-03

Installed by: IREDELL BACKHOE

Operation Permit by: STEVE HEDRICK date 12-29-03

Existing System Inspection by: ____ date ____

HEALTH DEPT. COPY: WHITE OWNER COPY (FINAL): YELLOW OWNER COPY (INITIAL): PINK