IREDELL COUNTY HEALTH DEPARTMENT

THIS PERMIT REPLACES PREVIOUS ISSUED 9-13-02

STATESVILLE 704-878-5305 MOORESVILLE 704-664-5281

IMPROVEMENT PERMIT / AUTHORIZATION TO CONSTRUCT / OPERATION PERMIT / EXISTING SYSTEM INSPECTION

PERMIT# 107684 PIN# 4722-56-0192 878-2376 DATE 11-17-03

OWNER OR CONTRACTOR MARVIN ALAN NORMAN PHONE: Business 704-~~237-5172~~ Home 704-528-4835

ADDRESS 122 COMPTON PARK RD STATESVILLE, NC 28677

LOCATION BUFFALO SHOALS ROAD, TL OLD MOUNTAIN ROAD TR COMPTON PARK ROAD 2ND & 3RD LOTS ON LEFT

SUBDIVISION A-RUMPLE BLOCK / SECTION _____ LOT 10 & 11 LOT AREA 250' x 296' SITE CLASS. PS DESIGN FLOW 480 L.T.A.R. 0.30 GPD/FT²

Septic Tank: 1000 Gallons; STB 1007 Date 11-10-03

Pump Tank: _____ Gallons; PT _____ Date _____

Pump Make: _____ Model _____ Serial No. _____

Nitrification Field: No Fields 1 Square Feet 1600 Linear Feet 540

No Lines SIX Trench Width 36" Max Trench Bottom Depth 36" Gravel Depth 12"

☑ New System ☐ Repair System Type: I, II, III, IV, V, VI

System Description: CONVENTIONAL, GRAVITY

Repair System Description: CONVENTIONAL, PUMP

Maintenance Agreement Required: ☐ Yes ☐ No

☑ House/Mod. Home No. Bedrooms 4

☐ Mobile Home No. Bathrooms 3

☐ Business No. Employees ____

☐ Other _____

☐ Slab ☐ Crawl Space ☐ Basement w/plumbing ☑ Basement wo/plumbing

Water Supply: ☑ Individual ☐ Public ☐ Community


WELL

Comments:/Conditions:


Comments:/Conditions: SEPTIC TANK WITH MARKER INSTALLED USING "TUFTITE" FILTER

SCALE: 1" = 60'

INITIAL SITE SKETCH

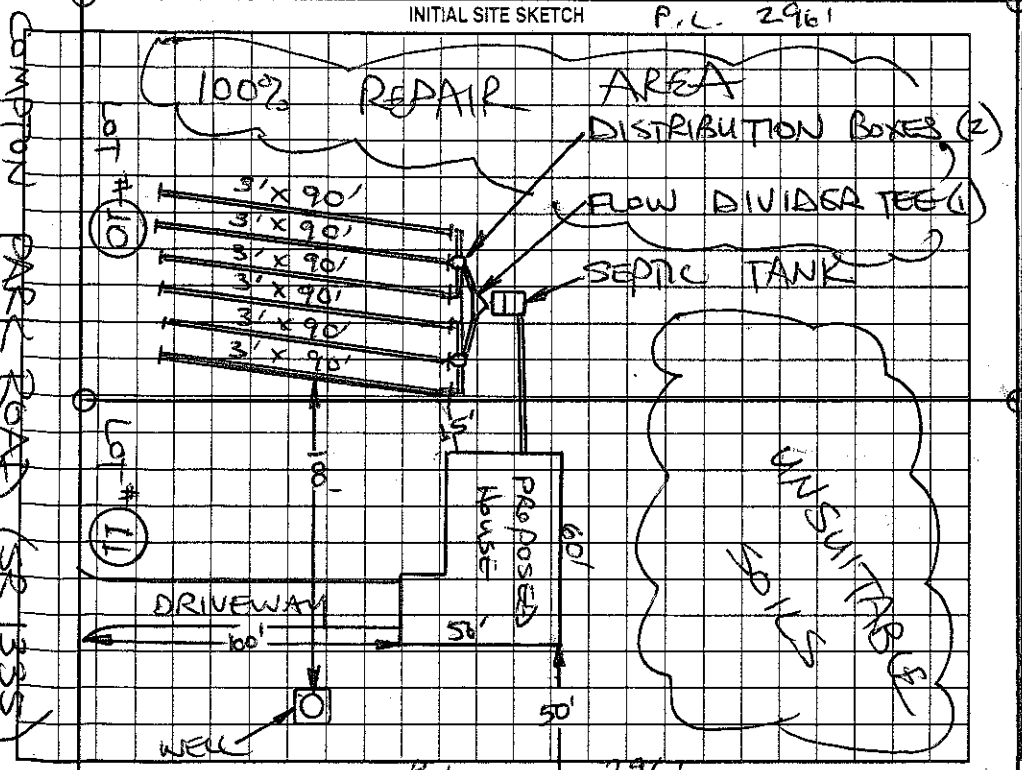

AS BUILT SKETCH

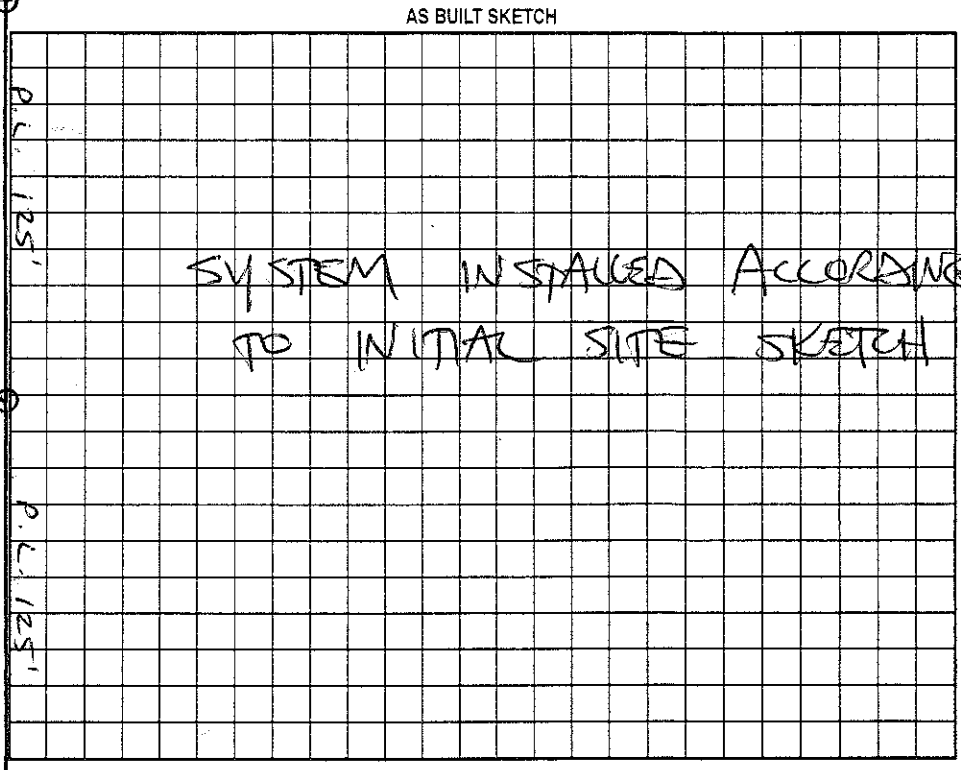

Permit can be suspended or revoked if any false information is supplied toward securing the permit/any unauthorized changes are made to the site/any unauthorized changes are made in the installation of the system. Improvement Permit with plat valid without expiration. Improvement Permit with site plan valid for sixty months. Authorization to Construct is valid for a period equal to that of Improvement Permit – not to exceed sixty months.

Signed: _____ date 12/1/03 Installed by: IREDELL BACKHOE

Improvement Permit by: STEVE HEDRICK date 11-17-03 Operation Permit by: STEVE HEDRICK date 12-29-03

Authorization to Construct by: STEVE HEDRICK date 11-17-03 Existing System Inspection by: _____ date _____

HEALTH DEPT. COPY: WHITE OWNER COPY (FINAL): YELLOW OWNER COPY (INITIAL): PINK