PIEDMONT CONST.

IREDELL COUNTY HEALTH DEPARTMENT

STATESVILLE 704-878-5305 MOORESVILLE 704-664-5281

IMPROVEMENT PERMIT / AUTHORIZATION TO CONSTRUCT / OPERATION PERMIT / EXISTING SYSTEM INSPECTION

PERMIT# 106803 PIN# 4722-56-4863 DATE 6-24-02

OWNER OR CONTRACTOR ~~JENNIFER LORD~~ Piedmont Const. PHONE: Business 704-736-4335 Home 704-742-0412

ADDRESS 101 ST. MARTIN LANE STATESVILLE NC 28677

LOCATION I-40 W TL OLD MTN. RD, TL RUMPLE HILL DR, LOT ON RIGHT AT ST. MARTIN LANE

SUBDIVISION LIPPARD SPRINGS BLOCK / SECTION I LOT 13 LOT AREA ~110'x230' SITE CLASS. PS DESIGN FLOW 360 L.T.A.R. 0.35 GPD/FT²

Septic Tank: 1000 Gallons; STB 801 Date 10/07/02

~~Pump Tank: 1000~~ Gallons; PT ____ Date ____

Pump Make: ____ Model ____ Serial No. ____

Nitrification Field: No Fields 1 Square Feet 1035 Linear Feet ~~345~~ 284

No Lines THREE Trench Width 36" Max Trench Bottom Depth 36" Gravel Depth 12"

☑ New System ☐ Repair System Type: I II III IV V VI

System Description: 75% CONVENTIONAL PUMP-TOO

Repair System Description: PUMP-75% CONVENTIONAL PUMP-TOO

Maintenance Agreement Required: ☐ Yes ☑ No

☑ House/Mod. Home ☐ Mobile Home ☐ Business ☐ Other

No. Bedrooms 3 No. Bathrooms 2 No. Employees ____


☐ Slab ☑ Crawl Space ☐ Basement w/plumbing ☐ Basement wo/plumbing

Water Supply: ☑ Individual ☐ Public ☐ Community WELL


Comments/Conditions: ① KEEP SYSTEM MINIMUM 100 FEET FROM WELL (15A NCAC 18A .1956(6)(g)) ② SEE ATTACHED SHEETS FOR PUMP AND PRESSURE MANIFOLD REQUIREMENTS.

Comments/Conditions: - SEPTIC TANK INSTALLED USING TANK MARKER + SIM/TECH FILTER. * SYSTEM INSTALLED AS SHOWN BELOW IN AS BUILT SKETCH. SYSTEM INSTALLED DURING MOIST SOIL CONDITIONS.

INITIAL SITE SKETCH SCALE: 1"=40'

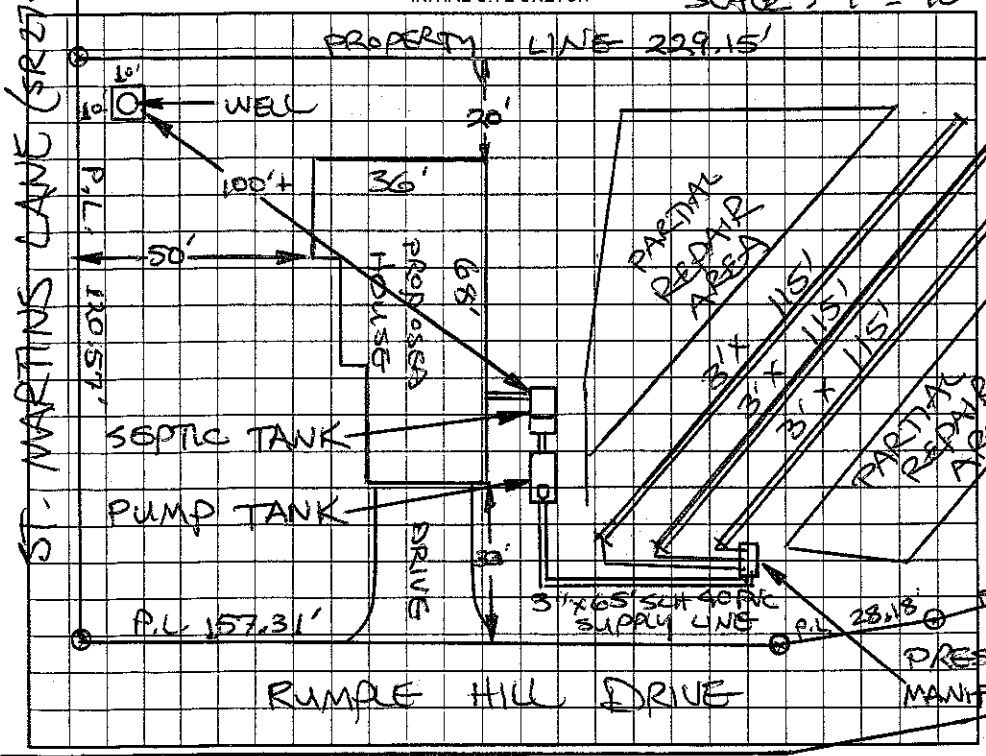

AS BUILT SKETCH

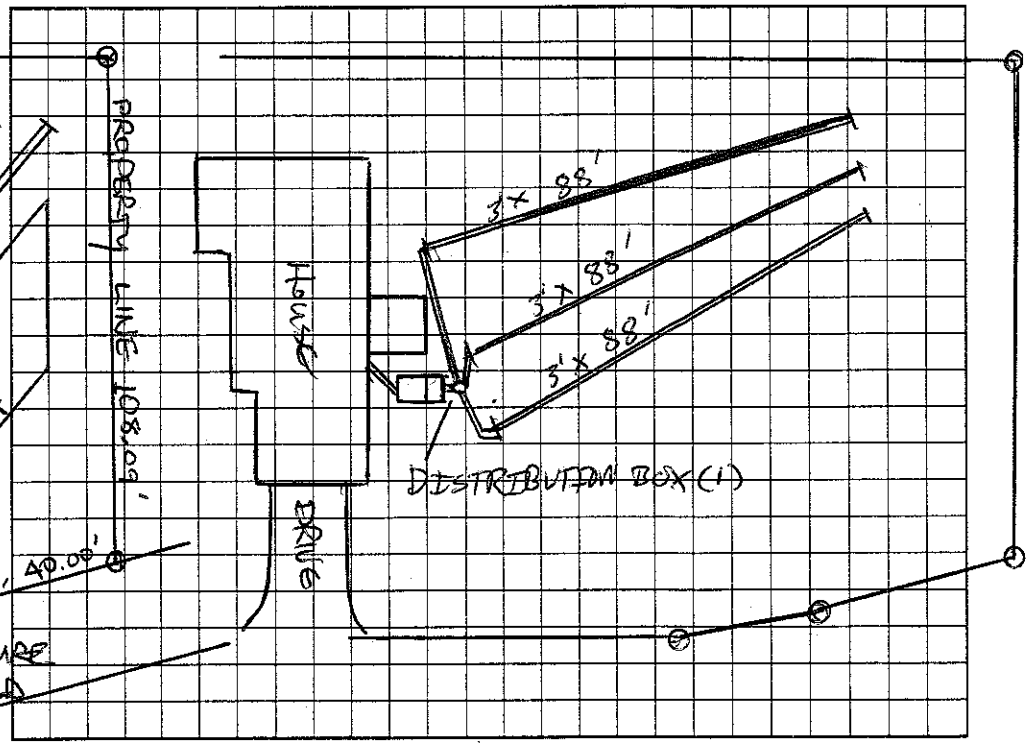

Permit can be suspended or revoked if any false information is supplied toward securing the permit/any unauthorized changes are made to the site/any unauthorized changes are made in the installation of the system. Improvement Permit with plat valid without expiration. Improvement Permit with site plan valid for sixty months. Authorization to Construct is valid for a period equal to that of Improvement Permit – not to exceed sixty months.

Signed: Gary Faulkenbury date 7-10-02 Installed by: RANDY ABERNATHY

Improvement Permit by: STEVE HEDRICK date 6-24-02 Operation Permit by: Patrick Mitchell date 01/21/03

Authorization to Construct by: STEVE HEDRICK date 6-24-02 Existing System Inspection by: ____ date ____

HEALTH DEPT. COPY: WHITE OWNER COPY (FINAL): YELLOW OWNER COPY (INITIAL): PINK