IREDELL COUNTY HEALTH DEPARTMENT

STATESVILLE 704-878-5305 (C) MOORESVILLE 704-664-5281

IMPROVEMENT PERMIT / AUTHORIZATION TO CONSTRUCT / OPERATION PERMIT / EXISTING SYSTEM INSPECTION

PERMIT# 108881 PIN# 4722567363 DATE 7/29/03

OWNER OR CONTRACTOR RW RORIE CONSTRUCTION PHONE: Business 664-4445 Home

ADDRESS 187 DRUM ST. LINCOLNTON, NC 28092

LOCATION OLD MOUNTAIN RD - ON LT JUST PAST RUMPLE HILL - GOING TOWARD TROUTMAN

SUBDIVISION LIPPARD SPRINGS BLOCK / SECTION LOT 8 LOT AREA 1.51AC SITE CLASS. PS DESIGN FLOW 360GPD L.T.A.R. .3640/PT2

Septic Tank: 1000 Gallons; STB 327 Date 12-27-04
Pump Tank: Gallons; PT Date
Pump Make: Model Serial No.
Nitrification Field: No Fields 1 Square Feet 900 Linear Feet 300
No Lines 4@75' Trench Width 36" Max Trench Bottom Depth 36" Gravel Depth N/A

☑ New System ☐ Repair System Type: I, II, III, IV, V, VI
System Description: GRAVITY 25% REDUCTION
Repair System Description: PANEL GRAVITY
Maintenance Agreement Required: ☐ Yes ☑ No


☑ House/Mod. Home No. Bedrooms 3
☐ Mobile Home No. Bathrooms 3
☐ Business No. Employees
☐ Other
☐ Slab ☑ Crawl Space ☐ Basement w/plumbing ☐ Basement wo/plumbing

Water Supply:
☑ Individual
☐ Public
☐ Community

Comments:/Conditions:

Comments:/Conditions: SEPTIC TANK WITH MARKER INSTALLED "USING RED "POLYLOK" FILTER

INITIAL SITE SKETCH 1" = 50'

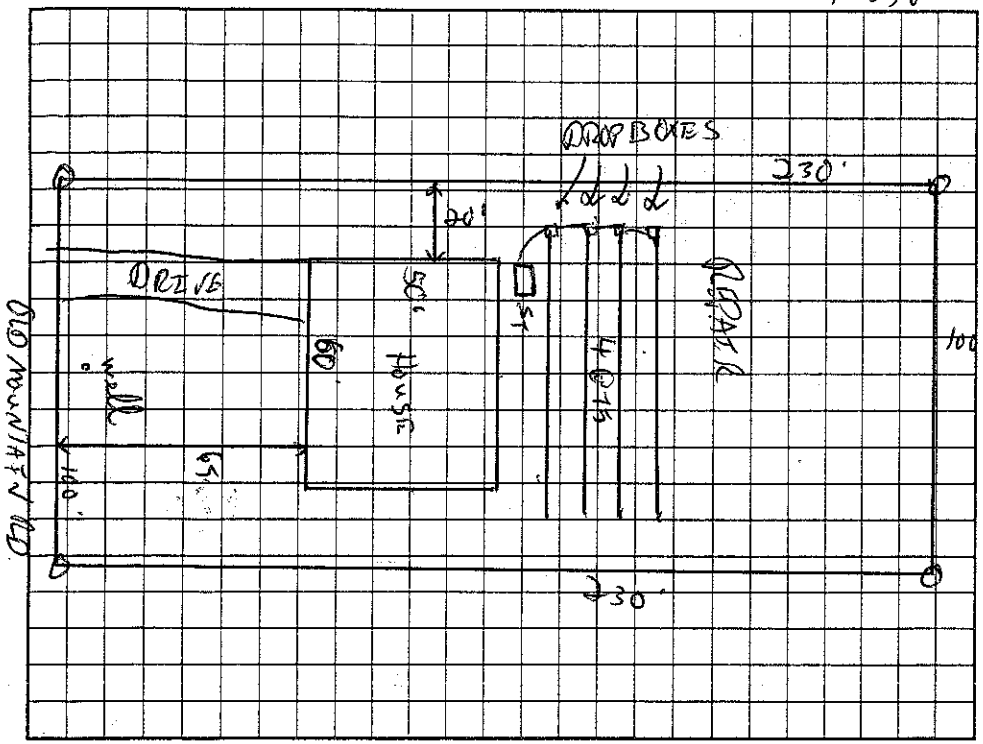

AS BUILT SKETCH

SYSTEM INSTALLED ACCORDING TO INITAL SITE SKETCH

Permit can be suspended or revoked if any false information is supplied toward securing the permit/any unauthorized changes are made to the site/any unauthorized changes are made in the installation of the system. Improvement Permit with plat valid without expiration. Improvement Permit with site plan valid for sixty months. Authorization to Construct is valid for a period equal to that of Improvement Permit – not to exceed sixty months.

Signed: Russell Rorie date 8-11-03 Installed by: G & M ENTERPRISES

Improvement Permit by: [signature] date 7/29/03 Operation Permit by: STEVE HEDRICK date 3-11-05

Authorization to Construct by: William O. Johnson date 11/15/04 Existing System Inspection by: date

HEALTH DEPT. COPY: WHITE OWNER COPY (FINAL): YELLOW OWNER COPY (INITIAL): PINK