IREDELL COUNTY HEALTH DEPARTMENT

STATESVILLE 704-878-5305 MOORESVILLE 704-664-5281

IMPROVEMENT PERMIT / AUTHORIZATION TO CONSTRUCT / OPERATION PERMIT / EXISTING SYSTEM INSPECTION

PERMIT# 76083 PIN# 4722 56 9467 DATE 8-28-98

OWNER OR CONTRACTOR Chris Davidson PHONE: Business _____ Home _____

ADDRESS PO Box 252 Statesville N.C.

LOCATION Own R Turn Rumple Hill TR St. martins 3 From entr on Rt. 138 St martins

SUBDIVISION Lippard Sp. BLOCK / SECTION _____ LOT _____ LOT AREA .78 SITE CLASS PS DESIGN FLOW 360 L.T.A.R. .125

Septic Tank: 1060 Gallons; STB 786 Date 3-5-98
Pump Tank: _____ Gallons; PT _____ Date _____
Pump Make: _____ Model _____ Serial No. _____
Nitrification Field: No Fields I Square Feet 1080 Linear Feet 360
No Lines 5 Trench Width 36" Max Trench Bottom Depth 36" Gravel Depth N/A

☑ New System ☐ Repair System Type: I, II, III, IV, V, VI
System Description: Gravity 25% Rock
Repair System Description: 12" 12" 12"
Maintenance Agreement Required: ☐ Yes ☑ No


☑ House/Mod. Home No. Bedrooms 3
☐ Mobile Home No. Bathrooms 2
☐ Business No. Employees ____
☐ Other _____
☐ Slab ☑ Crawl Space ☐ Basement w/plumbing ☐ Basement wo/plumbing

Water Supply: ☑ Individual ☐ Public ☐ Community


Comments:/Conditions:

Comments:/Conditions:

INITIAL SITE SKETCH

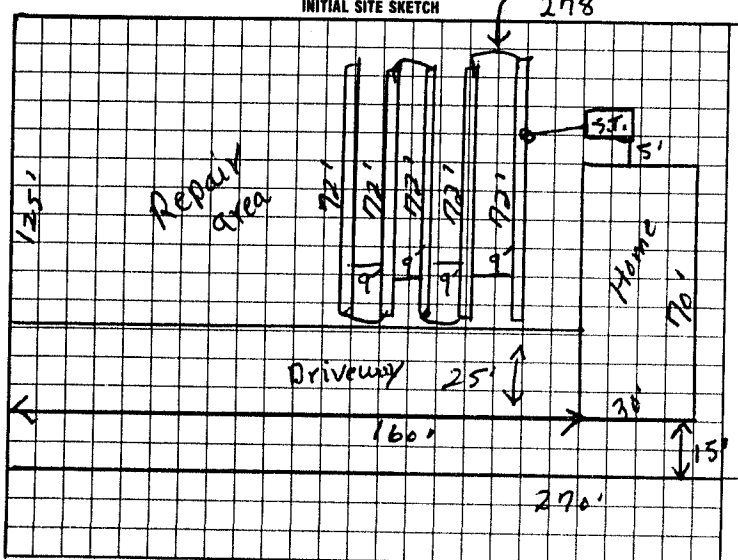

AS BUILT SKETCH

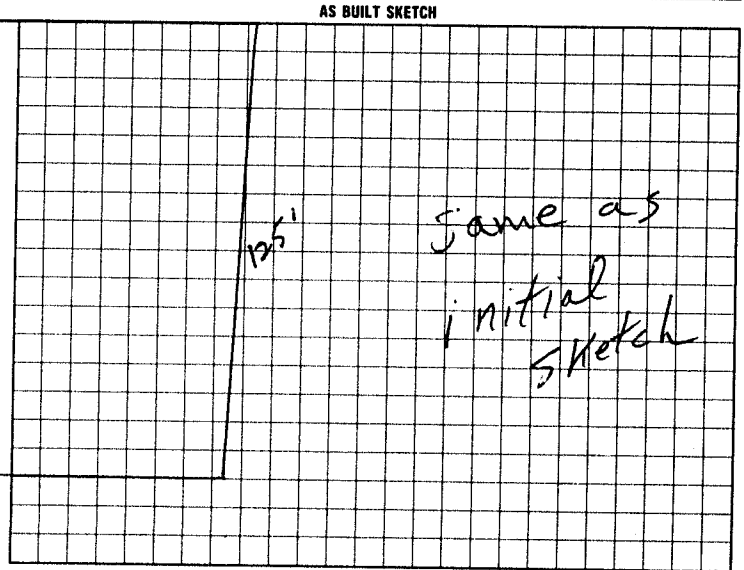

I understand that this permit can be suspended or revoked if any false information is supplied toward securing the permit/any unauthorized changes are made to the site/any unauthorized changes are made in the installation of the system. Improvement Permit with plat valid without expiration. Improvement Permit with site plan valid for sixty months. Authorization to Construct is valid for a period equal to that of Improvement Permit – not to exceed sixty months.

Signed: Neil Kale date 9-8-98

Improvement Permit by: P.C. Moore date 8-28-98

Authorization to Construct by: P.C. Moore date 8-28-98

Installed by: Charlie Brice (Catawba Co.)

Operation Permit by: P.C. Moore date 4-23-99

Existing System Inspection by: _____ date _____

HEALTH DEPT. COPY: WHITE INSPECTION COPY (FINAL): GREEN OWNER COPY (FINAL) YELLOW INSPECTION COPY (INITIAL) PINK OWNER COPY (INITIAL) GOLD