47505

IREDELL COUNTY HEALTH DEPARTMENT

STATESVILLE 704-878-5305 MOORESVILLE 704-664-5281

IMPROVEMENT PERMIT / CERTIFICATE OF COMPLETION / OPERATION PERMIT / EXISTING SYSTEM INSPECTION

TAX MAP NO. 6C-6-A-16

PROPERTY DESCRIPTION NO. 15787 DATE 9-29-93 PHONE: Business Home

OWNER OR CONTRACTOR David L. Sharpe

ADDRESS

LOCATION I40W TL old mtn Rd TL Lippard Springs Lot #27 SITE CLASS. P.S. L.T.A.R. .3gpd/ft2

SUBDIVISION Lippard Springs BLOCK / SECTION LOT 27 LOT AREA

Water Supply: ☑ Individual ☐ Community ☐ Public

Septic Tank: 1250 Gallons: STB 564 Date 6-6-93

Pump Tank: Gallons: PT Date

Nitrification Field: No Fields Square Feet 1200 Linear Feet 400'

☑ No Lines 4 Trench Width 36" Trench Depth 18"-36" Gravel Depth 12"

☑ New System ☐ Repair System Type: I (II) III, IV, V, VI

System Description: conventional, gravity

Repair System Description: Pump to PPBPS

Maintenance Agreement Required: ☐ Yes ☑ No

☑ House/Mod. Home ☐ Mobile Home ☐ Business ☑ Other 1/2 basement

No. Bedrooms 3 No. Bathrooms 2 No. Employees -

☐ Slab ☑ Crawl Space ☑ Basement w/plumbing ☐ Basement wo/plumbing

Garbage Disposal: ☑ Yes ☐ No

Auto. Dishwasher: ☑ Yes ☐ No


Auto. Washing Machine: ☑ Yes ☐ No

Other

Comments Inserted 2 step downs in each line but the last line to keep system in the ground (out of contour). slotted pipe used initially in trenches, contractor had to replace with right type pipe. 100% Repair Area above house, pump to PPBPS. Maintenance agreement required for repair.

INITIAL SITE SKETCH

AS BUILT SKETCH

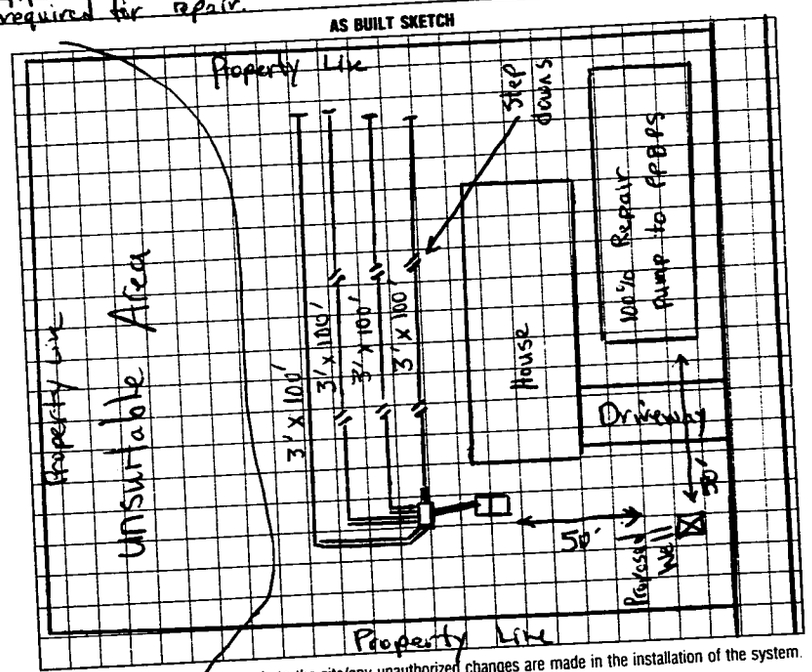

I understand that this permit can be suspended or revoked if any false information is supplied toward securing the permit/any unauthorized changes are made to the site/any unauthorized changes are made in the installation of the system. Improvement Permit is valid for 60 months from date of issuance.

Signed:

Improvement Permit by: J.C. Moore date 2-8-93

Existing System Inspection by: date

Installed by: David Sharpe

Certificate of Completion by: Michael J. Dennis date 9-29-93

Operation Permit by: date

HEALTH DEPT. COPY: WHITE INSPECTION COPY (FINAL): GREEN OWNER COPY (FINAL): YELLOW INSPECTION COPY (INITIAL): PINK OWNER COPY (INITIAL): GOLD