IREDELL COUNTY HEALTH DEPARTMENT

STATESVILLE 704-878-5305 MOORESVILLE 704-664-5281

IMPROVEMENT PERMIT / CERTIFICATE OF COMPLETION / OPERATION PERMIT / EXISTING SYSTEM INSPECTION

PROPERTY DESCRIPTION NO. 069275 DATE 9-2-97 TAX MAP NO. 4722-57 3019 Watershed: ☐ Yes ☐ No

OWNER OR CONTRACTOR Heritage Bldg Co. PHONE: Business 704-528-6644 Home

ADDRESS 120 Hickory Hill Ct, Statesville

LOCATION Buffalo Shoals Tb old mtn Tb Rumple Drive 4th lot Left

SUBDIVISION Lippard Sp. BLOCK / SECTION LOT 36 LOT AREA 125'x200' SITE CLASS. PS DESIGN FLOW 360 L.T.A.R. .13

Septic Tank: 1000 Gallons; STB 1012 Date 9-4-97

Pump Tank: Gallons; PT Date

Pump Make: Model Serial No.

Nitrification Field: No Fields 1 Square Feet 1200 Linear Feet 400

No Lines 4 Trench Width 36" Max Trench Bottom Depth 36" Gravel Depth 12"

☑ New System ☐ Repair System Type: I, II, III, IV, V, VI

System Description: Conv. Gravity

Repair System Description: Gravity panel

Maintenance Agreement Required: ☐ Yes ☑ No

☑ House/Mod. Home No. Bedrooms 3

☐ Mobile Home No. Bathrooms 2

☐ Business No. Employees

☐ Other


☐ Slab ☑ Crawl Space ☐ Basement w/plumbing ☐ Basement wo/plumbing

Water Supply: ☑ Individual ☐ Community ☐ Public


Comments:

Comments:

INITIAL SITE SKETCH

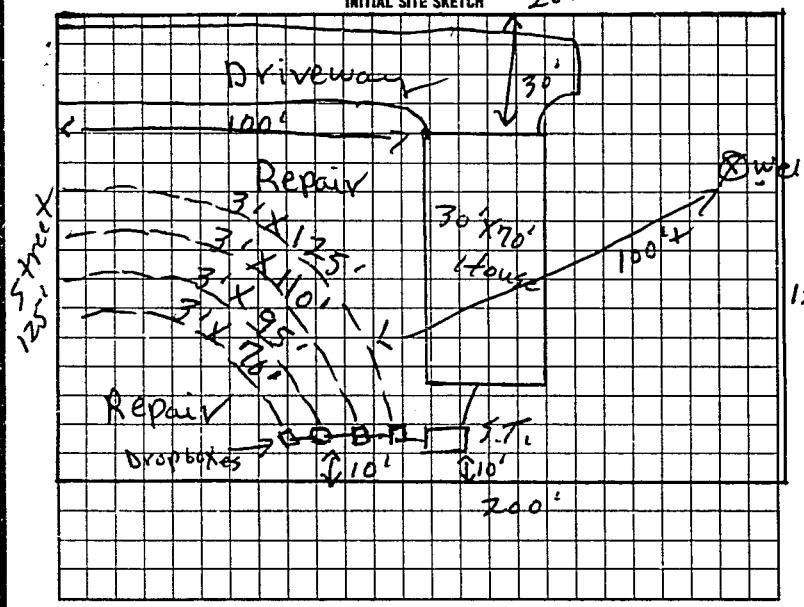

AS BUILT SKETCH

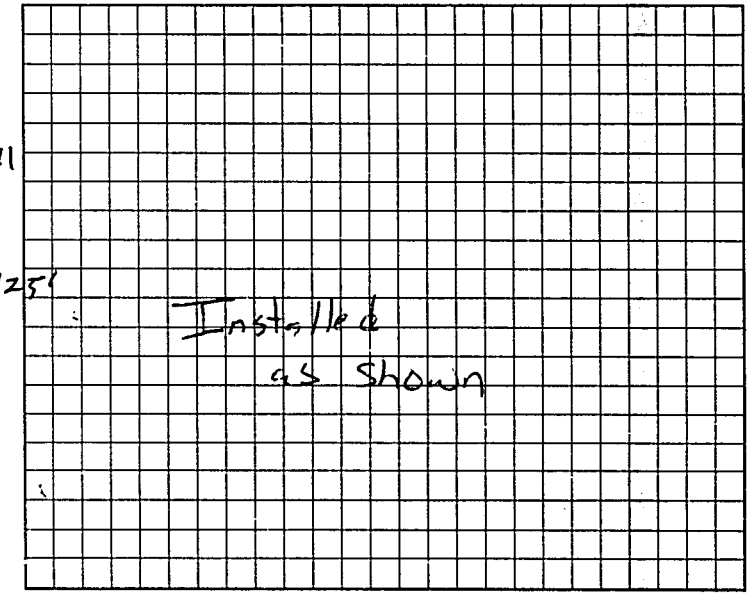

I understand that this permit can be suspended or revoked if any false information is supplied toward securing the permit/any unauthorized changes are made to the site/any unauthorized changes are made in the installation of the system. Improvement Permit is valid for 60 months from date of issuance.

Signed:

Improvement Permit by P. C. Moore date 9-2-97

Authorization to Construct P. C. Moore date 9-2-97

Installed by: Tammy Frye

Certificate of Completion by: date

Operation Permit by Mary C. Lutz RS date 9-8-97

HEALTH DEPT COPY WHITE INSPECTION COPY (FINAL) GREEN OWNER COPY (FINAL) YELLOW INSPECTION COPY (INITIAL) PINK OWNER COPY (INITIAL) GOLD

Authorization to Construct Expires 60 mos from issue

8601 00