IREDELL COUNTY HEALTH DEPARTMENT

STATESVILLE 704-878-5305 MOORESVILLE 704-664-5281

IMPROVEMENT PERMIT / CERTIFICATE OF COMPLETION / OPERATION PERMIT / EXISTING SYSTEM INSPECTION

PROPERTY DESCRIPTION NO. 69272 DATE 9-2-97 TAX MAP NO. 4722 57 3260 Watershed: ☐ Yes ☐ No

OWNER OR CONTRACTOR Heritage Bldg Co PHONE: Business 704 528 4444 Home

ADDRESS 120 Hickory Pt Ct Sta

LOCATION Buffalo Shoals Rd TL Alexander TL Burnside Hill Dr. 5th lot left

SUBDIVISION Lippard SP BLOCK / SECTION LOT 37 LOT AREA 125'x200' SITE CLASS. PS DESIGN FLOW 360 L.T.A.R. .33

Septic Tank: 1000 Gallons; STB 1012 Date 9-9-97

Pump Tank: Gallons; PT Date

Pump Make: Model Serial No. 360

Nitrification Field: No Fields 1 Square Feet 1000 Linear Feet ~~400~~

No Lines 4 Trench Width 36" Max Trench Bottom Depth 36" Gravel Depth 12"

☑ New System ☐ Repair System Type: I, II, III, IV, V, VI

System Description: Conv. Gravity

Repair System Description: Gravity Chambers

Maintenance Agreement Required: ☐ Yes ☑ No

☑ House/Mod. Home ☐ Mobile Home ☐ Business ☐ Other

No. Bedrooms 3 No. Bathrooms 2 No. Employees


☐ Slab ☑ Crawl Space ☐ Basement w/plumbing ☐ Basement wo/plumbing

Water Supply: ☑ Individual ☐ Community ☐ Public


Comments:

Comments:

INITIAL SITE SKETCH

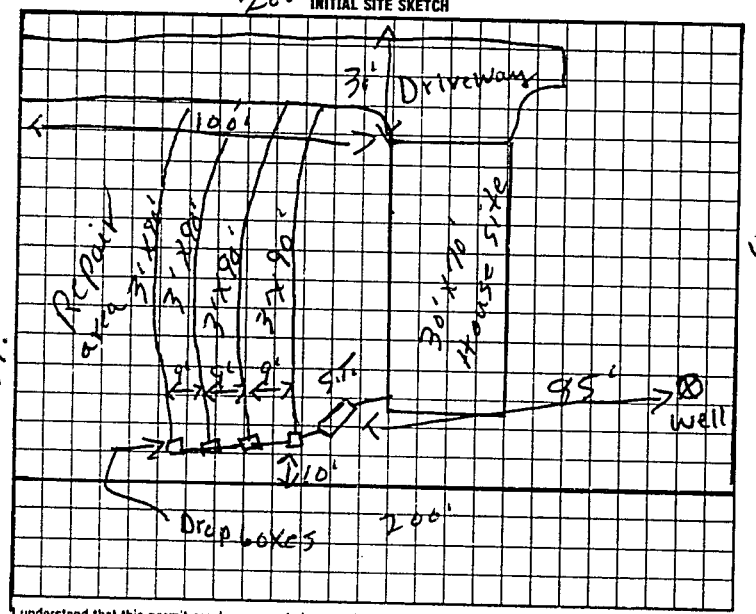

AS BUILT SKETCH

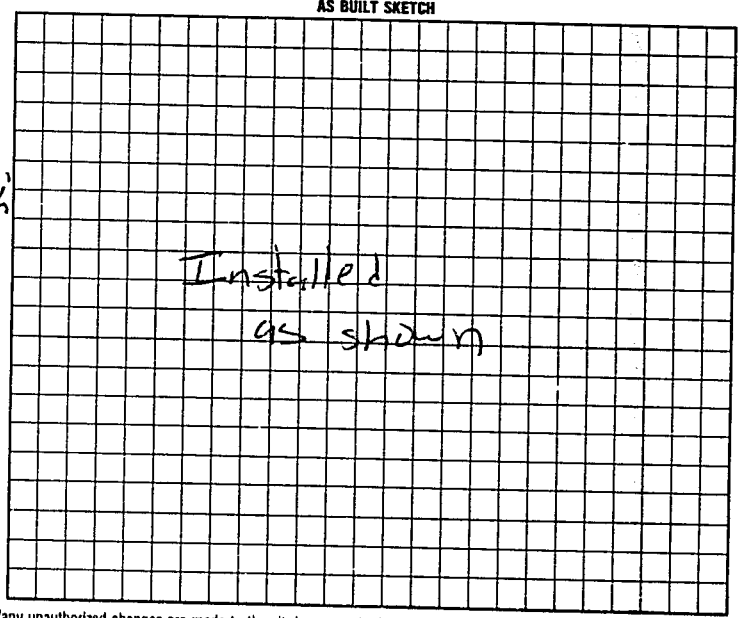

I understand that this permit can be suspended or revoked if any false information is supplied toward securing the permit/any unauthorized changes are made to the site/any unauthorized changes are made in the installation of the system. Improvement Permit is valid for 60 months from date of issuance.

Signed

Improvement Permit by: R. C. Moore date 9-2-97

Existing System Inspection by: Authorization to Cont. R. C. Moore date 9-2-97

Installed by: Tommy Fryl

Certificate of Completion by: date

Operation Permit by: RS date 12-8-97

Authorization to Cont. EXPIRES 60 mos From issue

HEALTH DEPT. COPY: WHITE INSPECTION COPY (FINAL): GREEN OWNER COPY (FINAL): YELLOW INSPECTION COPY (INITIAL): PINK OWNER COPY (INITIAL): GOLD