10:00

CI

IREDELL COUNTY HEALTH DEPARTMENT

STATESVILLE 704-878-5305 MOORESVILLE 704-664-5281

IMPROVEMENT PERMIT / AUTHORIZATION TO CONSTRUCT / OPERATION PERMIT / EXISTING SYSTEM INSPECTION

PERMIT# 35888 PIN# 4722 57 3570 DATE 6-15-06

OWNER OR APPLICANT ROBERT D & DANIEL L IRBY PHONE: Business 704-528-4840 Home 704-252-1007

ADDRESS 157 RUMPLE HILL DR Statesville, NC 28677

LOCATION BUFFALO SHOALS RD (D) OLD MTN RD (R) RUMPLE HILL Bottom of hill on LEFT.

SUBDIVISION Lippard Springs BLOCK / SECTION III LOT 39 LOT AREA 0.964 SITE CLASS. PS DESIGN FLOW 360 L.T.A.R. .8

Septic Tank: 1000 Gallons; STB 1012 Date 10-23-06

Pump Tank: 1000 Gallons; PT 17 Date 3-10-07

Pump Make: GOULDS Model WED 3127M0 Serial No. ~~D07674~~

Nitrification Field: No Fields 1 Square Feet EQ=1200' Linear Feet 300'

No Lines 3x100' Trench Width 36" Max Trench Bottom Depth 36" Gravel Depth N/A ☐ Gravity ☒ Pressure

☒ New System ☐ Repair ☐ Expansion System Type: I II (III) IV V VI

System Description: PUMP 25% REDUCTION

Repair System Description: LP 50% REDUCTION

Maintenance Agreement Required: ☐ Yes ☒ No

☒ House/Mod. Home ☐ Mobile Home ☐ Business ☐ Other

No. Bedrooms 3 No. Persons 6 No. Employees

Water Supply: ☒ Individual ☐ Public ☐ Community


☐ Slab ☐ Crawl Space ☒ Basement w/plumbing ☐ Basement wo/plumbing

Comments:/Conditions: (1) EXPLAINED ALL SETBACKS WITH OWNER & GRADER DUE TO Complexity of the lot (2) INSTALL LINES ON CONTOURS (3) ~~MAINTAIN~~ SETBACKS


Comments:/Conditions: TUFF TITE F. Hx & MORKER

NO BASEMENT PLUMBING

INITIAL SITE SKETCH

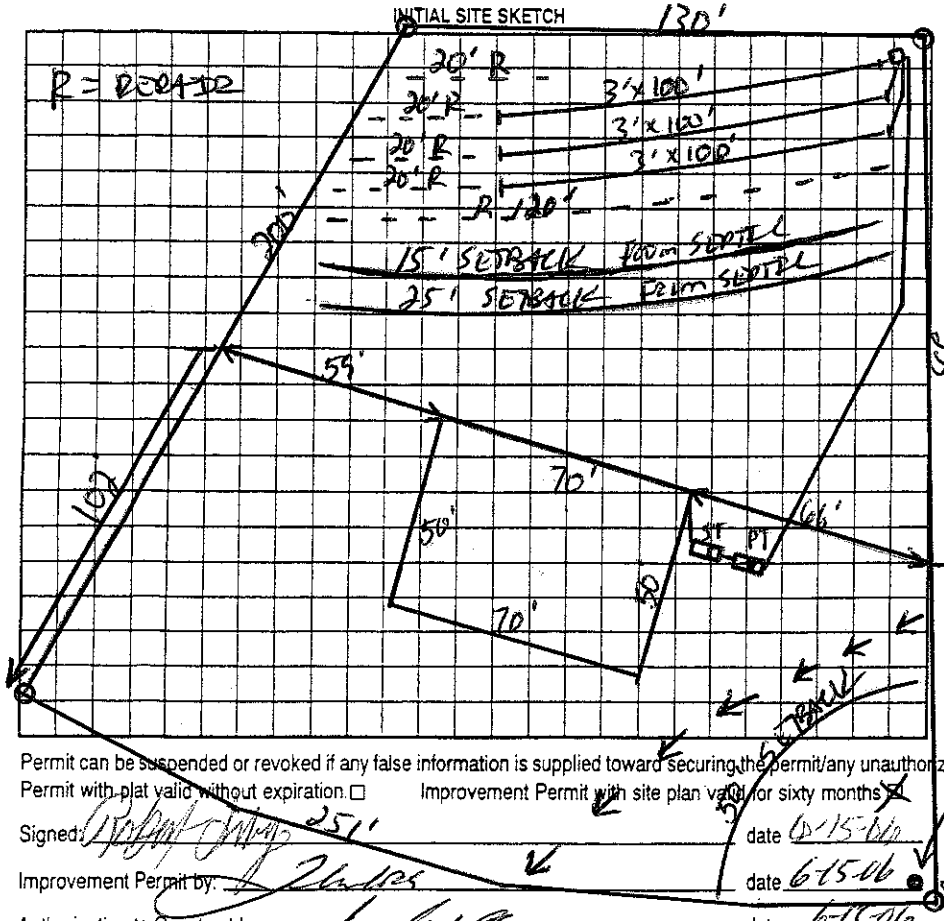

AS BUILT SKETCH

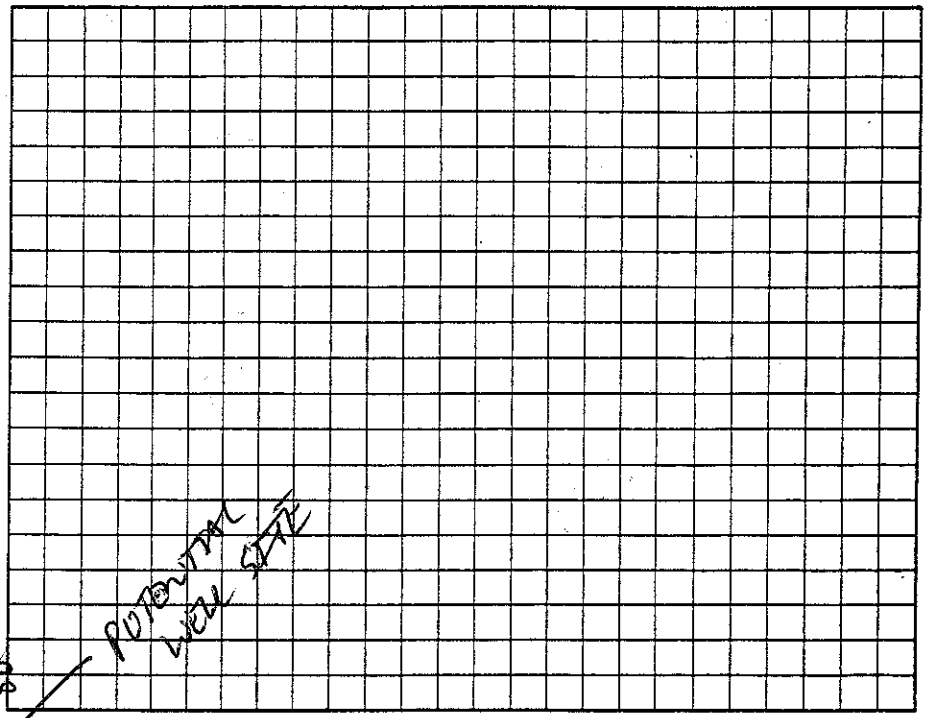

Permit can be suspended or revoked if any false information is supplied toward securing the permit/any unauthorized changes are made to the site/any unauthorized changes are made in the installation of the system. Improvement Permit with plat valid without expiration. ☐ Improvement Permit with site plan valid for sixty months ☒ Authorization to Construct is valid for a period equal to that of Improvement Permit – not to exceed sixty months.

Signed: _____ date 6-15-06 Installed by: Steve Jordan

Improvement Permit by: _____ date 6-15-06 Operation Permit by: _____ date 5-30-07

Authorization to Construct by: _____ date 6-15-06 Existing System Inspection by: _____ date _____

HEALTH DEPT. COPY: WHITE OWNER COPY (FINAL): YELLOW OWNER COPY (INITIAL): PINK